

STATE ENGINEER
Salem, Oregon

UMAT
5113

Well Record

GR- 1118

STATE WELL NO. 6N/35-35E(1)
COUNTY Umatilla
APPLICATION NO. GR-1154

OWNER: Clay A. Grogan


MAILING ADDRESS: Rt. 3, Box 376

LOCATION OF WELL: Owner's No.

CITY AND STATE: Milton-Freewater, Oregon

SE 1/4 SW 1/4 Sec. 35 T. 6 N. R. 35 E. W.M.

Bearing and distance from section or subdivision
corner 105' W. & 14' N. from SE cor. of N 1/2 of
SE 1/4 SW 1/4 of Sec. 35.

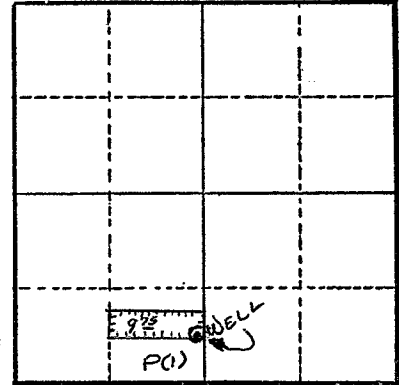

Section 35

Altitude at well 950 ft.

TYPE OF WELL: Dug Date Constructed 1902

Depth drilled 26 ft. Depth cased 12 ft.

CASING RECORD:

60" x 60" concrete curb 0 to 12 ft.

FINISH:

AQUIFERS:

WATER LEVEL:

16 ft.

PUMPING EQUIPMENT: Type 2 in. Cent. H.P. 2

Capacity 225 G.P.M.

WELL TESTS:

Drawdown 8.5 ft. after 225 hours G.P.M.

Drawdown ft. after hours G.P.M.

USE OF WATER Irrigation Temp. °F. 19

SOURCE OF INFORMATION G. R. Record

DRILLER or DIGGER

ADDITIONAL DATA:

Log Water Level Measurements Chemical Analysis Aquifer Test

REMARKS:

Log: Gravel top soil 0 to 1 1/2 ft.
Cement gravel 1 1/2 to 26 ft.

Irrigation of 9 3/4 acres.