

STATE ENGINEER  
Salem, Oregon

UMAT  
5114

# Well Record

STATE WELL NO. 6N/35-35  
COUNTY UMATILLA  
~~APPLICATION NO.~~ GR-2825

OWNER: H. G. Duggan


MAILING ADDRESS: Box 172 Garibaldi, Oregon

LOCATION OF WELL: Owner's No. \_\_\_\_\_

CITY AND STATE: \_\_\_\_\_

$S\frac{1}{2}$  SE  $\frac{1}{4}$  SW  $\frac{1}{4}$  Sec. 35 T. 6 ~~S~~, R. 35 ~~W~~, W.M.

Bearing and distance from section or subdivision corner 168' W. and 46' N.

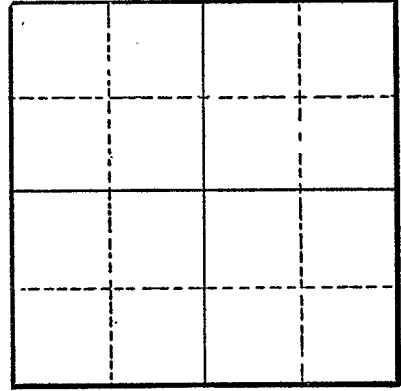

Section \_\_\_\_\_

Altitude at well \_\_\_\_\_

TYPE OF WELL: dug Date Constructed 1895

Depth drilled 23 Depth cased 7

### CASING RECORD:

8' x 10'

### FINISH:

### AQUIFERS:

Top soil and rock

### WATER LEVEL:

15-feet

PUMPING EQUIPMENT: Type Centrifugal H.P. 3  
Capacity 200 G.P.M.

### WELL TESTS:

Drawdown \_\_\_\_\_ ft. after \_\_\_\_\_ hours \_\_\_\_\_ G.P.M.  
Drawdown \_\_\_\_\_ ft. after \_\_\_\_\_ hours \_\_\_\_\_ G.P.M.

USE OF WATER irrigation Temp. \_\_\_\_\_ °F. \_\_\_\_\_, 19

SOURCE OF INFORMATION GR-2664

DRILLER or DIGGER \_\_\_\_\_

ADDITIONAL DATA:  
Log  Water Level Measurements \_\_\_\_\_ Chemical Analysis \_\_\_\_\_ Aquifer Test \_\_\_\_\_

### REMARKS:

Topsoil 4 4  
Cement rock 19 23