

STATE ENGINEER
Salem, Oregon

UMAT
5154

Well Record

STATE WELL NO. 6N/35-36E1
COUNTY UMATILLA
APPLICATION NO.

OWNER: M. Grogan MAILING ADDRESS:

LOCATION OF WELL: Owner's No. CITY AND STATE:


1/4 1/4 Sec. T. N. S, R. E. W., W.M.

Bearing and distance from section or subdivision corner

Altitude at well 935

TYPE OF WELL: Drilled Date Constructed

Depth drilled 740 Depth cased 500

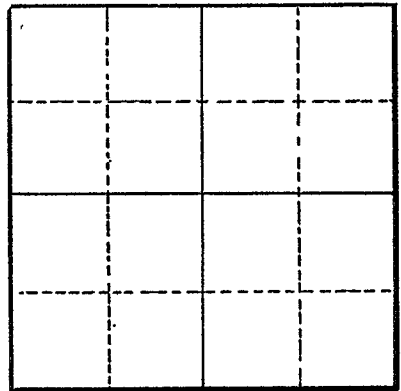

Section

CASING RECORD:
8 inch

FINISH:

AQUIFERS:

Basalt from 550 to 740

WATER LEVEL:

100 feet below land surface, 1931

PUMPING EQUIPMENT: Type Turbine H.P.
Capacity 150 G.P.M.

WELL TESTS:

Drawdown ft. after hours G.P.M.
Drawdown ft. after hours G.P.M.

USE OF WATER Irrigation Temp. °F., 19

SOURCE OF INFORMATION USGS

DRILLER or DIGGER

ADDITIONAL DATA:

Log Water Level Measurements Chemical Analysis Aquifer Test

REMARKS:

Penetrated thick zone of blue clay over basalt struck at about 450 feet.