

STATE ENGINEER
Salem, Oregon



Well Record

STATE WELL NO. 6/35-36P
COUNTY Umatilla
APPLICATION NO. GR-3493

OWNER: Lawrence Gutte


MAILING ADDRESS: 408 N. Elizabeth

LOCATION OF WELL: Owner's No.

CITY AND STATE: Medford, Oregon

SE 1/4 SW 1/4 Sec. 36 T. 6 N. S., R. 35 W., W.M.

Bearing and distance from section or subdivision corner 400' W. & 50' N. of SE cor. of SW 1/4

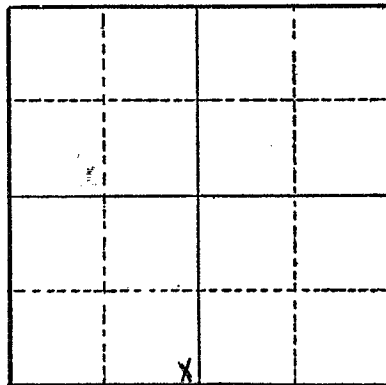

Section 36

Altitude at well

TYPE OF WELL: Dug Date Constructed 1920

Depth drilled 43 ft. Depth cased

CASING RECORD:

FINISH:

AQUIFERS:

WATER LEVEL:

25 feet below surface

PUMPING EQUIPMENT: Type Centrifugal H.P. 3
Capacity 180 G.P.M.

WELL TESTS:

Drawdown 5 ft. after hours 180 G.P.M.
Drawdown ft. after hours G.P.M.

USE OF WATER Irrigation Temp. °F., 19

SOURCE OF INFORMATION Well Registration Statement

DRILLER or DIGGER

ADDITIONAL DATA:

Log Water Level Measurements Chemical Analysis Aquifer Test

REMARKS: