

STATE ENGINEER
Salem, Oregon

UMAT
5157

Well Record

STATE WELL NO. 6N/35-36B
COUNTY Umatilla
APPLICATION NO. GR-3844

OWNER: Oland F. Hubbs
Ebev. L. Hurst


MAILING ADDRESS: Route 1, Box 39

LOCATION OF WELL: Owner's No. _____

CITY AND STATE: Milton-Freewater, Oregon

NW 1/4 NE 1/4 Sec. 36 T. 6 ~~S~~ N. R. 35 ~~W.~~ E., W.M.

Bearing and distance from section or subdivision
corner 660' E. & 1300' S. from N 1/4 Cor., Sec. 36

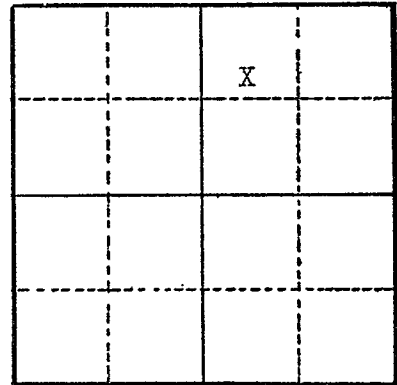

Section 36

Altitude at well _____

TYPE OF WELL: Dug 30' Date Constructed 1914
Drilled 228'
Depth drilled 258 ft. Depth cased _____

CASING RECORD:

8 inch casing set from 30' to

FINISH:

Perforated

AQUIFERS:

WATER LEVEL:

12 feet below surface

PUMPING EQUIPMENT: Type Johnston turbine 5" H.P. 5
Capacity 450 G.P.M.

WELL TESTS:

Drawdown about 60 ft. after _____ hours 450 G.P.M.
Drawdown _____ ft. after _____ hours _____ G.P.M.

USE OF WATER Irrigation Temp. _____ °F., 19

SOURCE OF INFORMATION Well Registration Statement Cert. # CR-3501

DRILLER or DIGGER _____

ADDITIONAL DATA:

Log _____ Water Level Measurements _____ Chemical Analysis _____ Aquifer Test _____

REMARKS: