

STATE ENGINEER  
Salem, Oregon

UMAT  
5158

# Well Record


STATE WELL NO. 6N/35-36N  
COUNTY Umatilla  
APPLICATION NO. GR-3578

OWNER: Jack LeFore MAILING ADDRESS: Box 324

LOCATION OF WELL: Owner's No. \_\_\_\_\_ CITY AND STATE: Milton-Freewater, Oregon

SE 1/4 SW 1/4 Sec. 36 T. 6 N., R. 35 E., W.M.

Bearing and distance from section or subdivision corner 820 ft. E. and 10 ft. N. from SW corner Sec. 36

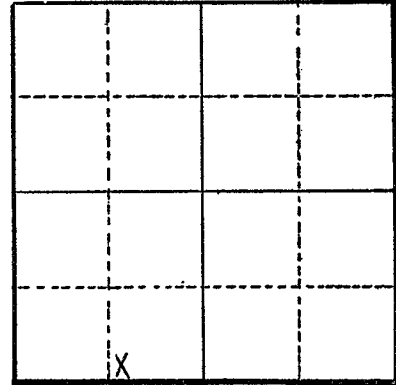

Altitude at well \_\_\_\_\_

TYPE OF WELL: Dug & Drill Date Constructed 1911

Depth drilled 220 ft. Depth cased 55 ft.

Section 36

### CASING RECORD:

8 1/2 inch concrete casing set from 0 to 12 ft.  
8 inch steel casing set from 35 to 55 ft.

### FINISH:

### AQUIFERS:

### WATER LEVEL:

15 feet below surface

PUMPING EQUIPMENT: Type Rainflow centrifugal electric H.P. 5  
Capacity 125 G.P.M.

### WELL TESTS:

Drawdown \_\_\_\_\_ ft. after \_\_\_\_\_ hours \_\_\_\_\_ G.P.M.  
Drawdown \_\_\_\_\_ ft. after \_\_\_\_\_ hours \_\_\_\_\_ G.P.M.

USE OF WATER Irrigation Temp. \_\_\_\_\_ °F., 19\_\_\_\_

SOURCE OF INFORMATION Well Registration Statement

DRILLER or DIGGER Earl Shortridge

### ADDITIONAL DATA:

Log  Water Level Measurements \_\_\_\_\_ Chemical Analysis \_\_\_\_\_ Aquifer Test \_\_\_\_\_

### REMARKS:

Log: Drilled clay formation at 174'  
No other information