

STATE ENGINEER  
Salem, Oregon

UMAT  
5190

# Well Record

STATE WELL NO. 6N/36-25R  
COUNTY UMATILLA  
APPLICATION NO. GR-2649

OWNER: Floyd Gosselin


MAILING ADDRESS: 1116 W. B. Street

LOCATION OF WELL: Owner's No.

CITY AND STATE: Pasco, Washington

SE 1/4 SE 1/4 Sec. 25 T. 6 N. S. R. 36 E. W.M.

Bearing and distance from section or subdivision corner 2820' S. 993' W.

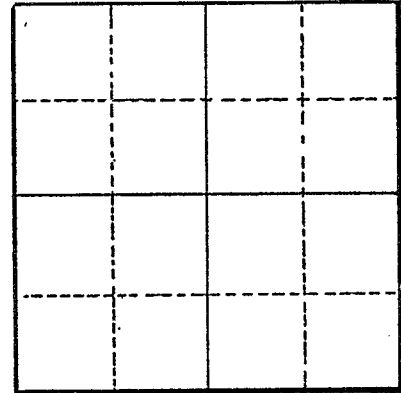

Altitude at well

TYPE OF WELL: Dug Date Constructed 1925

Depth drilled 28 Depth cased 7

Section

## CASING RECORD:

72 x 72 - inch

## FINISH:

## AQUIFERS:

Topsoil, gravelly

## WATER LEVEL:

12-feet

PUMPING EQUIPMENT: Type Centrifugal H.P. 2  
Capacity 125 G.P.M.

## WELL TESTS:

Drawdown 5 ft. after hours Pumping 125 G.P.M.  
Drawdown ft. after hours G.P.M.

USE OF WATER Irrigation Temp. °F. 19  
SOURCE OF INFORMATION GR-2510

DRILLER or DIGGER

## ADDITIONAL DATA:

Log X Water Level Measurements Chemical Analysis Aquifer Test

## REMARKS:

Topsoil gravelly  
Cemented gravel

2 2  
26 28