

STATE ENGINEER
Salem, Oregon

UMAT
5222

Well Record

STATE WELL NO. 6N/36-30N(1)
COUNTY Umatilla
APPLICATION NO. GR-1129

GR- 1089

OWNER: Millard M. Wise


MAILING ADDRESS: Rt. 1, Box 48A

LOCATION OF WELL: Owner's No.

CITY AND STATE: Milton-Freewater, Oregon

SW 1/4 SW 1/4 Sec. 30 T. 6 N. R. 36 E., W.M.

Bearing and distance from section or subdivision corner 729' N. & 21' E. from SW cor. Sec. 30.

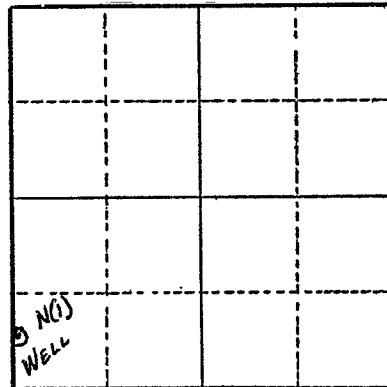

Section 30

Altitude at well 850 ft.

TYPE OF WELL: Dug & Drilled Date Constructed 1920

Depth drilled 72 ft. Depth cased 46 ft.

CASING RECORD:

38 x 40 in. concrete collar from 0 to 12 ft.
8 inch steel casing from 26 to 46 ft.

FINISH:

AQUIFERS:

WATER LEVEL:

6 ft.

PUMPING EQUIPMENT: Type 1 1/2 in. Cent. H.P. 3

Capacity 100 G.P.M.

WELL TESTS:

Drawdown 20 ft. after 100 hours G.P.M.

Drawdown ft. after hours G.P.M.

USE OF WATER Irrigation Temp. °F. 19

SOURCE OF INFORMATION G. R. Record

DRILLER or DIGGER

ADDITIONAL DATA:

Log Water Level Measurements Chemical Analysis Aquifer Test

REMARKS:

Log: Top soil 0 to 3 ft.
Cemented gravel 3 to 72 ft.

Irrigation of 5 1/2 acres.