

STATE ENGINEER
Salem, Oregon

UMNT
5240

Well Record

GR- 1151

STATE WELL NO. 6N/36-31E
COUNTY Umatilla
APPLICATION NO. GR- 1190

OWNER: Chris B. Johnson

MAILING

ADDRESS: Rt. 1, Box 143

LOCATION OF WELL: Owner's No.


CITY AND

STATE: Milton-Freewater, Oregon

SW 1/4 NW 1/4 Sec. 31 T. 6 N. R. 36 E. W.M.

Bearing and distance from section or subdivision

corner 164' S. & 132' E. of NW Cor. of SW 1/4 NW 1/4 of Section 31.

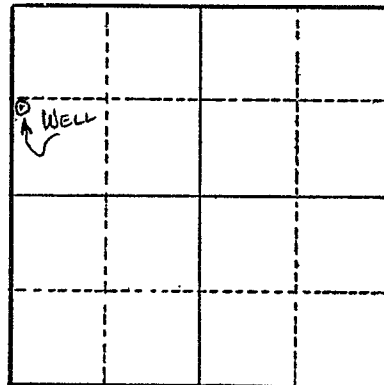

Section 31

Altitude at well 850 ft.

TYPE OF WELL: Dug & drilled Date Constructed Prior to 1920

Depth drilled 55 ft. Depth cased ??

CASING RECORD:

5 1/2 in. cribbed with 2 x 6 & concrete pipe from 1 to 16 ft.
6 in. steel pipe from 15 to ??? ft.

FINISH:

AQUIFERS:

WATER LEVEL:

PUMPING EQUIPMENT: Type 1 1/2 x 2 in. Cent. H.P. 2
Capacity 115 G.P.M.

WELL TESTS:

Drawdown 4 ft. after 115 hours G.P.M.
Drawdown ft. after hours G.P.M.

USE OF WATER Irrigation Temp. °F. 19

SOURCE OF INFORMATION G. R. Record

DRILLER or DIGGER

ADDITIONAL DATA:

Log Water Level Measurements Chemical Analysis Aquifer Test

REMARKS:

Log: Top soil 0 to 16 ft.
Gravel & sand 16 to 55 ft.

Irrigation of 25 acres.