


UMAT 002

T. 3N R. 29E

RECEIVED

APR - 6 1990

WATER RESOURCES DEPT.
SALEM, OREGON

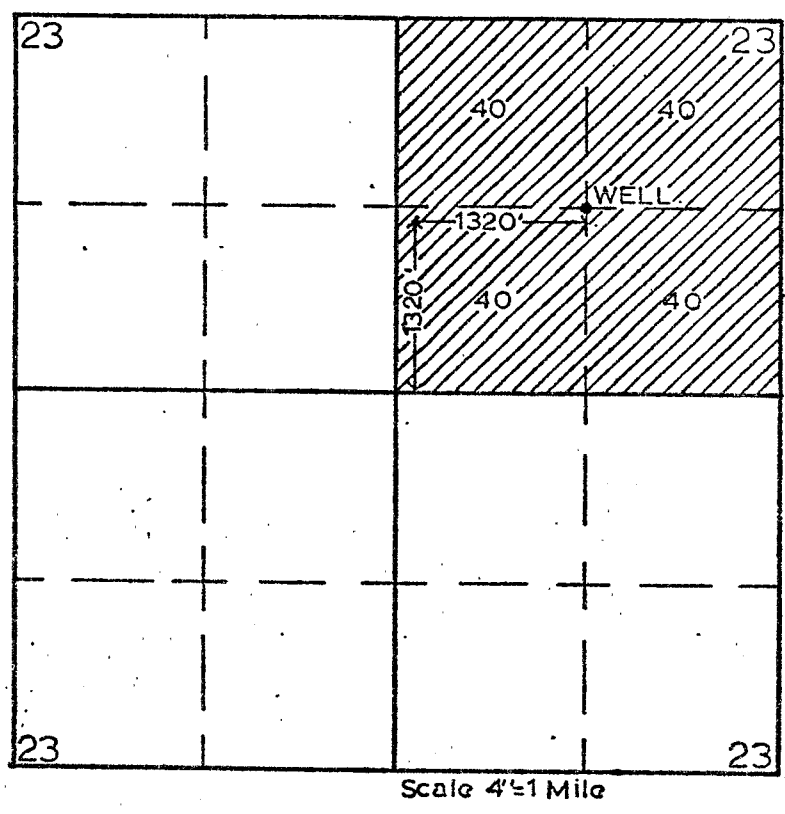

Kennth H. Coppinger Ranch

RECEIVED

APR 27 1990

WATER RESOURCES DEPT.
SALEM, OREGON