

9809C 10/85

UMAT 5468  
WELL IDENTIFICATION FORM

RECEIVED

FEB 20 1997

CURRENT WELL OWNER:

Owner's Well Number: WATER RESOURCES DEPT.  
SALEM, OREGON

Name: Chuck + Janet Nagle

Mailing Address: 16480 S. Archer Dr.

City: Oregon City State: OR Zip: 97045

*If a well report is available for this well, please attach a copy of it to this form and return. It is not necessary for you to complete the remainder of the form if the well report is attached. If a well report is not available, please complete the remainder of the form to the best of your ability.*

WELL LOCATION:

County: Umatilla Latitude: \_\_\_\_\_ Longitude: \_\_\_\_\_

Township: 6 N or S, Range: 35 E or W Section: 29 NW 1/4 NE 1/4

Tax Lot Number: 400

Street Address of Well (if different from above): Rt. 2 Box 302

WELL INFORMATION: No log available

Start Card Number: \_\_\_\_\_ Approx. Construction Date: \_\_\_\_\_

Well Constructor: \_\_\_\_\_

Name of Owner at Time of Construction: \_\_\_\_\_

Well Depth (in feet): \_\_\_\_\_ Static Water Level (in feet): \_\_\_\_\_

Diameter of Exposed Well Casing (in inches): \_\_\_\_\_

Does this well have a formal water right associated with it? Yes: \_\_\_\_\_ No: \_\_\_\_\_ If yes:

Application #: \_\_\_\_\_ Permit #: \_\_\_\_\_ Certificate #: \_\_\_\_\_

Please Return Completed Form to:

Oregon Water Resources Department  
158 12th Street NE  
Salem, OR 97310

(Office use only)

Well Identification Number: 13133

## FOR WATER RESOURCES DEPARTMENT USE ONLY

Date Postmarked 11-13-90  
 Date Hand-delivered \_\_\_\_\_  
 Watermaster Initials 405

W- 14869  
 WRD Receipt 69125  
 Date Fee Received 11-15-90

# START CARD

## NOTICE OF BEGINNING OF WELL CONSTRUCTION

(as required by ORS 537.762)

This form must be completed, signed by both the owner (or authorized agent) and constructor, and the original mailed or delivered to the Water Resources Department, 3850 Portland Road NE, Salem, OR 97310, no later than the day construction, alteration, conversion or abandonment work begins. A **\$75 fee shall accompany all notices for new well construction or conversion of an existing hole not previously used as a water well** (make checks payable to the Water Resources Department). Notices meeting this requirement but received without the required fee **will not be accepted** as properly and timely filed. The Water Resources Commission has authority to impose civil penalties for failure to submit the required \$75 fee with the start card and for failure to submit cards prior to beginning any construction, alteration, conversion or abandonment work.

Owner's name and mailing address R. Charles Nagele

16480 S. Archer Dr.

Oregon City, OR 97045

Check type of work: ☒ New construction ☐ Repair ☐ Recondition  
☐ Deepening ☐ Conversion ☐ Abandonment


Proposed Commencement Date Nov. 12, 1990

Existing or Proposed Well Depth 50 - 100 feet Diameter 6

Check Use: ☒ Domestic ☐ Community ☐ Industrial ☐ Irrigation ☐ Monitoring  
☐ Thermal ☐ Injection ☐ Other \_\_\_\_\_

Proposed Well Location: County Umatilla

Township 6N (N or S) Range 35 E (E or W) Section 29

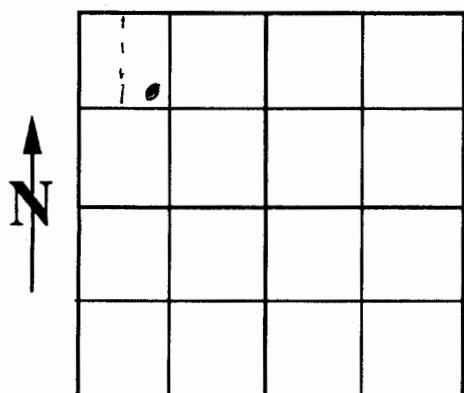

1. E 1/2 of NW 1/4 of NW 1/4 of above section
2. Street address of Umapine Hwy. & Hodgen Road  
well location \_\_\_\_\_
3. Tax lot number of well location 400 - 129636
4. Attach map with location identified.  
(See reverse of this form for approved maps)
5. Show well location within 1/4, 1/4 of section grid at left.

We hereby certify that we have read the back of this form, and that to the best of our knowledge the information provided herein is accurate and the well is being properly located from septic tanks and septic drain fields.

R. Charles Nagele  
 Owner's signature

Doreen J. Summer  
 Bonded Water Well Constructor

Owner 11-4-90  
 Title Date

License No. 575

655-1486  
 Home phone

251-6150  
 Work phone

Company GWS Summer Well Drilling

NOTE: This is not a water right application. The owner is responsible for obtaining a water right through the Water Resources Department, if required.

THIS COPY TO WATER RESOURCES DEPARTMENT IN SALEM  
 If no fee applies, discard this copy

**UMAT 5468**

NOV 15 1990

WATER RESOURCES DEPT.  
SALEM, OREGON

~~LEASE~~  
PROPERTY

