

STATE ENGINEER
Salem, Oregon

UMAT 57333
UMAT 57333 Well Record

STATE WELL NO. 6N/35-33K
COUNTY Umatilla
APPLICATION NO. GR-3861

OWNER: Archie Harris

MAILING ADDRESS:


LOCATION OF WELL: Owner's No.

CITY AND STATE:

Milton-Freewater, Oregon

NW 1/4 SE 1/4 Sec. 33 T. 6 N. E. S. R. 35 W. W.M.

Bearing and distance from section or subdivision corner 810' S. & 361' E. of center Sec. 33

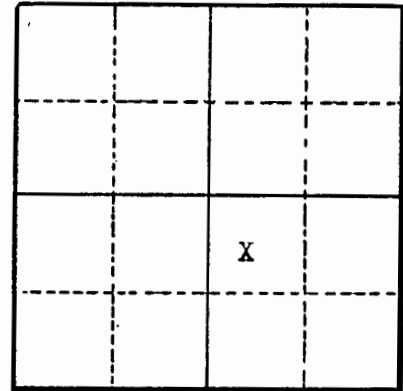

Section 33

Altitude at well

TYPE OF WELL: Dug Date Constructed prior 1927

Depth drilled 39 ft. Depth cased

CASING RECORD:

6' x 6' concrete curb

FINISH:

AQUIFERS:

WATER LEVEL:

20 - 40 feet below surface

PUMPING EQUIPMENT: Type 2" centrifugal H.P. 5
Capacity 160 G.P.M.

WELL TESTS:

Drawdown ft. after hours G.P.M.

Drawdown ft. after hours G.P.M.

USE OF WATER Irrigation Temp. °F. 19

SOURCE OF INFORMATION Well Registration Statement Cert. # GR-3633

DRILLER or DIGGER

ADDITIONAL DATA:

Log X Water Level Measurements Chemical Analysis Aquifer Test

REMARKS:

Log: Cement gravel and loose gravel