STATE OF OREGON WATER WELL REPORT (as required by ORS 537.765)

ORIGINAL & FIRST COPY - WATER RESOURCES DEPARTMENT


RECEIVED
972700EB 1 0 1994

4N/29E/6	
TART CARD)# 5337/	

(as required by ORS 351.703)	(START CARD) #	
(1) OWNER: Well Number SALEM,	OURCES DEPT. OPELOGATION OF WELL by legal description:	
Name Walter Klinpstein	County (a Latitude Longitude	
Address R+ 5 Bx 5229	Township 4 Nor S. Range 29 Ebr W. W	VM.
City Hown is ton State Of Zip 97838		
7 0 0		
2) TYPE OF WORK:		
New Well Deepen Recondition Abandon	Street Address of Well (or nearest address) Baster Ag	
3) DRILL METHOD:	Herm, ston	<u> </u>
Rotary Air Rotary Mud Cable	(10) STATIC WATER LEVEL:	7/
Other	(10) STATIC WATER LEVEL: 35 ft. below land surface. Date 4-9	47
4) PROPOSED USE:	Artesian pressure lb. per square inch. Date	
Domestic Community Industrial Irrigation	(11) WATER BEARING ZONES:	
Thermal Injection Other		
(5) BORE HOLE CONSTRUCTION:	Depth at which water was first found	
	Deput at which water was first found	
Special Construction approval Yes No Depth of Completed Well 203 ft.	From To Estimated Flow Rate S	SWL
Explosives used Yes No Type Amount		14
HOLE SEAL Amount		
Diameter From To Material From To sacks or pounds	158 175 35 3	>5
10 0 57 coment 0 57 18555		
657203	* ',	
	(12) WELL LOG:	
	Ground elevation	
Iow was seal placed: Method A B B C D E	L. C.	
	Material From To S	SWL
Other	5) / O / Z	
sackfill placed from ft. to ft. Material		
Gravel placed from ft. to ft. Size of gravel	COURSE DIACK Sand 12 3	
6) CASING/LINER:	Black Basalt 51 146	
Diameter From To Gauge Steel Plastic Welded Threaded	Drug Basalt 146 158	
Casing: + 1 57 250 A	Wisicular Basuf 158 195.	<u> 55</u>
	Black Basalt 185 203	
		1
	- *	
Liner:		
Final location of shoe(s)		
(7) PERFORATIONS/SCREENS:	100	
` ′		
Perforations Method	4	
Screens Type Material		
Slot Tele/pipe		
From To size Number Diameter size Casing Liner		
	l ez :	
(8) WELL TESTS: Minimum testing time is 1 hour	7 2 2 1 2 1 2	
Flowing	Date started 2-3-94 Completed 2-4-9	<u> </u>
☐ Pump ☐ Bailer Air ☐ Artesian	(unbonded) Water Well Constructor Certification:	_
Yield gal/min Drawdown Drill stem at Time	I certify that the work I performed on the construction, alteration, or ab	
	ment of this well is in compliance with Oregon well construction standards. M	
35 203 1 hr.	used and information reported above are true to my best knowledge and bel	
	WWC Number	
	Signed Date	
Temperature of Water Depth Artesian Flow Found	(bonded) Water Well Constructor Certification:	selr
	I accept responsibility for the construction, alteration, or abandonment we formed on this well during the construction dates reported above. All work per	ork pe
Was a water analysis done? Yes By whom	during this time is in compliance with Oregon well construction standards. Thi	
Did any strata contain water not suitable for intended use? Too little	to the tree of my lenguiled an and haliaf	
☐ Salty ☐ Muddy ☐ Odor ☐ Colored ☐ Other	is true to the best of my knowledge and benef. WWC Number Z	
Depth of strata:	Signed Notes Date 2-7-	ァイ

SECOND COPY - CONSTRUCTOR THIRD COPY - CUSTOMER

9809C 10/91

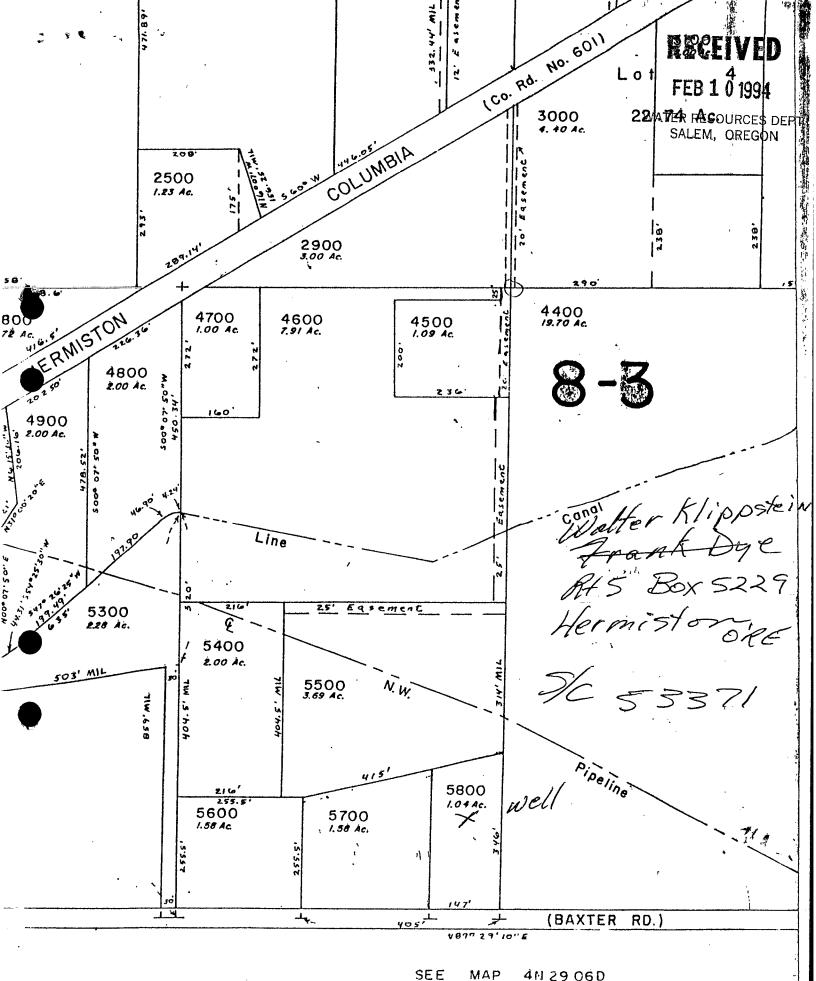

SEE 4N 29 06D