

STATE ENGINEER
Salem, Oregon



Well Record


GR- 1630

STATE WELL NO. 6N/35-36K
COUNTY Umatilla
APPLICATION NO. GR- 1596

OWNER: Willa M. Arnoldt MAILING ADDRESS: Rt. 1, Box 167

LOCATION OF WELL: Owner's No. _____ CITY AND STATE: Milton-Freewater, Oregon

NW 1/4 SE 1/4 Sec. 36 T. 6 N. 35 E. W.M.
Bearing and distance from section or subdivision
corner 60' N. & 705' W. from SE cor. of NW 1/4 SE 1/4
of Section 36.

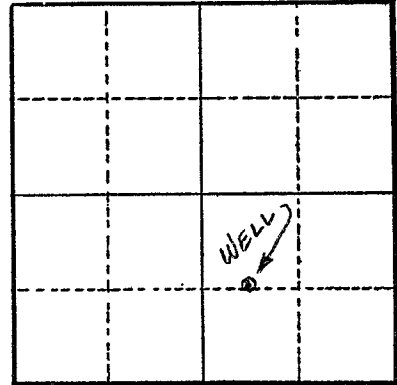

Section 36

Altitude at well 950'

TYPE OF WELL: Dug & Drill'd Date Constructed 1920 Prior to
Depth drilled 90' Depth cased 51'

CASING RECORD:

72" x 84" concrete curbing from 0 to 20 ft.
8" steel from 36 to 51 ft.

FINISH:

AQUIFERS:

WATER LEVEL:

15'

PUMPING EQUIPMENT: Type 4" turbine H.P. 5
Capacity 400 G.P.M.

WELL TESTS:

Drawdown 15 ft. after _____ hours 400 G.P.M.
Drawdown _____ ft. after _____ hours _____ G.P.M.

USE OF WATER Irrigation Temp. _____ °F. _____, 19____

SOURCE OF INFORMATION GR Record

DRILLER or DIGGER _____

ADDITIONAL DATA:

Log _____ Water Level Measurements _____ Chemical Analysis _____ Aquifer Test _____

REMARKS:

Log: Top soil 0 to 2 ft.
Cement gravel 2 to 90 ft.

Irrigation of 10 acres.