

STATE ENGINEER  
Salem, Oregon

UMAT  
6198

# Well Record

STATE WELL NO. 6N/35-20P  
COUNTY Umatilla  
APPLICATION NO. GR-1271

GR- 1227

OWNER: Charles Orville Alexander

MAILING ADDRESS: Rt. 2, Box 175


LOCATION OF WELL: Owner's No.

CITY AND STATE: Milton-Freewater, Oregon

SE 1/4 SW 1/4 Sec. 20 T. 6 N. R. 35 E. W.M.

Bearing and distance from section or subdivision

corner 8' N. & 2' W. from S 1/4 cor. Sec. 20.

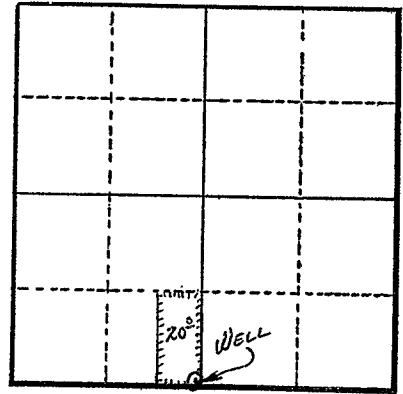

Section 20

Altitude at well 825 ft.

TYPE OF WELL: Dug Date Constructed 1924

Depth drilled 29 ft. Depth cased 14 ft.

### CASING RECORD:

6 x 6 ft. concrete curb from 0 to 14 ft.

### FINISH:

### AQUIFERS:

### WATER LEVEL:

15 ft.

PUMPING EQUIPMENT: Type Berkeley 2 in. Cent. H.P. 3  
Capacity G.P.M.

### WELL TESTS:

Drawdown 13 ft. after August hours 200 G.P.M.

Drawdown 2 ft. after June hours 200 G.P.M.

USE OF WATER Irrigation Temp. °F. 19

SOURCE OF INFORMATION G. R. Record

DRILLER or DIGGER

### ADDITIONAL DATA:

Log Water Level Measurements Chemical Analysis Aquifer Test

### REMARKS:

Log: Rock, dirt & sand 0 to 9 ft.  
Gravel 9 to 19 ft.  
Cement gravel 19 to 29 ft.

Irrigation of 20 acres.