

STATE ENGINEER
Salem, Oregon

UMAT 6199
UMAW 6119 Record

STATE WELL NO. 6N/35-200
COUNTY UMATILLA
APPLICATION NO. GR-2248

OWNER: Ralph P. Lile or Jet Lile


MAILING ADDRESS: Rt 2

LOCATION OF WELL: Owner's No.

CITY AND STATE: Milton, Oregon

SW 1/4 SE 1/4 Sec. 20 T. 6 N. R. 35 E., W.M.

Bearing and distance from section or subdivision corner 50' N from apoint 32' W from SE cor

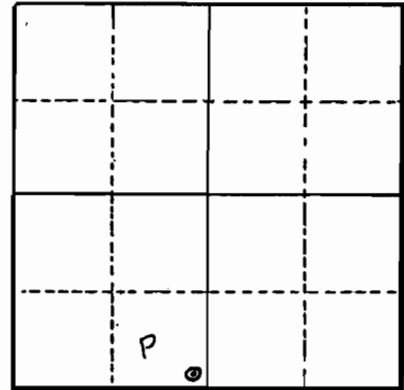

Altitude at well

TYPE OF WELL: Dug; Drilled Date Constructed 1912

Depth drilled 65' Depth cased 56'

Section 20

CASING RECORD:

8-inch

FINISH:

AQUIFERS:

cement

WATER LEVEL:

35'

PUMPING EQUIPMENT: Type Centrifugal

H.P. 3

Capacity 125 G.P.M.

WELL TESTS:

Drawdown 60 ft. after hours Unk G.P.M.

Drawdown ft. after hours G.P.M.

USE OF WATER Irrigation

Temp. °F. 19

SOURCE OF INFORMATION GR-3861

DRILLER or DIGGER

ADDITIONAL DATA:

Log Water Level Measurements Chemical Analysis Aquifer Test

REMARKS:

Dug part - 20' cement curb
6' X 6'