

UMAT  
62

# Well Record

STATE WELL NO. 132-9N(1)  
COUNTY UMATILLA  
APPLICATION NO. \_\_\_\_\_

OWNER: Pilot Rock Lumber Co.


MAILING ADDRESS: \_\_\_\_\_

LOCATION OF WELL: Owner's No. \_\_\_\_\_

CITY AND STATE: \_\_\_\_\_

SW 1/4 SW 1/4 Sec. 9 T. 1 S., R. 32 E., W.M.

Bearing and distance from section or subdivision corner \_\_\_\_\_

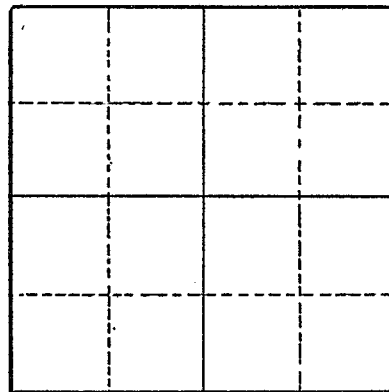

Section \_\_\_\_\_

Altitude at well \_\_\_\_\_

TYPE OF WELL: drilled Date Constructed \_\_\_\_\_

Depth drilled 36.5 Depth cased 41'

CASING RECORD:

10"

FINISH:

AQUIFERS:

BASALT

WATER LEVEL:

6' Reported

PUMPING EQUIPMENT: Type TURBINE H.P. \_\_\_\_\_  
Capacity 1500 G.P.M.

WELL TESTS:

Drawdown \_\_\_\_\_ ft. after \_\_\_\_\_ hours \_\_\_\_\_ G.P.M.  
Drawdown \_\_\_\_\_ ft. after \_\_\_\_\_ hours \_\_\_\_\_ G.P.M.

USE OF WATER INDUSTRIAL Temp. 64 °F., 19 \_\_\_\_\_

SOURCE OF INFORMATION USGS report Pg 84

DRILLER or DIGGER \_\_\_\_\_

ADDITIONAL DATA:

Log X Water Level Measurements \_\_\_\_\_ Chemical Analysis \_\_\_\_\_ Aquifer Test \_\_\_\_\_

REMARKS:

Reportedly supplied 415 AC.FT. OF WATER during water year 1954; see table 2 for log.