
File Original and First Copy with the STATE ENGINEER, SALEM, OREGON

STATE ENGINEER WELL REPORT
SALEM, GREGON

	· · · · · · · · · · · · · · · · · · ·
JM A TY	21/2 21
1 25 1	1777-61
Etate Well N	0

State Permit No. .....

(1) OWNER: Name Torren & Nagele	(11) WELL TESTS:  Drawdown is amount water level is lowered below static level  Was a pump test made? Yes Do If yes, by whom?  Driller		
Address 16025.W. GOODWIN PLACE	Was a pump test made? Yes \( \subseteq \text{No If yes, by who yield; 170} \) gal./min. with \( \frac{50}{10} \) ft. drawdo:	1111	8
PENDLETON, OREBON	" " gar./mm. with yo it. drawdo	vii alter	hrs.
	2) )) ))		,,
(2) LOCATION OF WELL:	Bailer test gal./min. with ft. drawdown after		hrs.
County Malella Owner's number, if any	Artesian flow g.p.m. Date		
14 N. W. 14 Section 2 / T. 2 N R. 3 2 W.M.	Temperature of water Was a chemical analysis made? Yes		es □ No
Bearing and distance from section or subdivision corner			
LOT I BLOCK 2 SUNSET	(12) WELL LOG: Diameter of well  Depth drilled ft. Depth of completed to		inches.
WALLEY TRACTS	Formation: Describe by color, character, size of mater show thickness of aquifers and the kind and nature of stratum penetrated, with at least one entry for each	al and stri the mater change of	icture, and ial in each formation.
	MATERIAL '	FROM	TO
(3) TYPE OF WORK (check):	Soil	0	2
New Well □ Deepening □ Reconditioning ☑ Abandon □	Clav	2	17.
If abandonment, describe material and procedure in Item 11.	Gravel	14	26
PROPOSED VISE (1 - 1). (C) EVIDE OF VIEW V.	Clay red rock	26	40
(4) PROPOSED USE (check): (5) TYPE OF WELL:	Broken Brown Rock	40	111
Domestic   Industrial   Municipal   Rotary   Driven   Cable   Jetted	Black rock	111	90
Irrigation  Test Well Other  Dug  Bored	Gray_rock	90	102
(C) CACING INSTALLED.	Red_rock	102	129
(6) CASING INSTALLED: Threaded Welded V	Gray rock	129	164
"Diam. from ft. to ft. Gage ft. Gage	Black rock	164	174
"Diam. fromft. toft. Gage	Gray rock	174	196
Diani. Hom	Red rock	196	222
(7) PERFORATIONS: Perforated?   Yes No	Black Rock	222	235
Type of perforator used	Brown rock	235	265
SIZE of perforations in. by in.			<del></del>
perforations from ft. to ft.		<del> </del>	
perforations from		<del> </del>	<del> </del>
perforations from ft. to ft.		<del>                                     </del>	+
perforations fromft. toft.			<del> </del>
perforations from ft. to ft.			
(8) SCREENS: Well screen installed ☐ Yes No		-	1
Manufacturer's Name			
Type Model No	,	1	
Discontinuous Slot size			
Slot size Set from ft. to ft.	Work started 3/29 19 60 Completed 1	<u> </u>	19 60
(9) CONSTRUCTION:	(13) PUMP:		
Was well gravel packed?   Yes No Size of gravel:	Manufacturer's Name	***************************************	
Gravel placed from ft. to ft.	Туре: Н.Р.		
Was a surface seal provided?			
Material used in seal—	Well Driller's Statement:		
Did any strata contain unusable water? Yes No	This well was drilled under my jurisdiction true to the best of my knowledge and belief.	and this	report is
Type of water? Depth of strata		•	ž.
Method of sealing strata off	NAME Ben Dreyer Drilling Conty		
(10) WATER LEVELS:	Route 2 Box 73BB, Pendle	Type or prince ton. O	
Static level 170 ft. below land surface Date 4/18/60	Address Cass 2, 2022 1, 2007 1 of the case		
Artesian pressure lbs. per square inch Date	Driller's well number		4
Log Accepted by:	[Signed] Ben Maller		
James - Moonta 7-27 1060	(Weil Driller)	**************************************	/^
[Signed] (Owner) Date	License No. 12 Date 7/2		, 19.60
(USE ADDITIONAL SI	HEETS IF NECESSARY)		

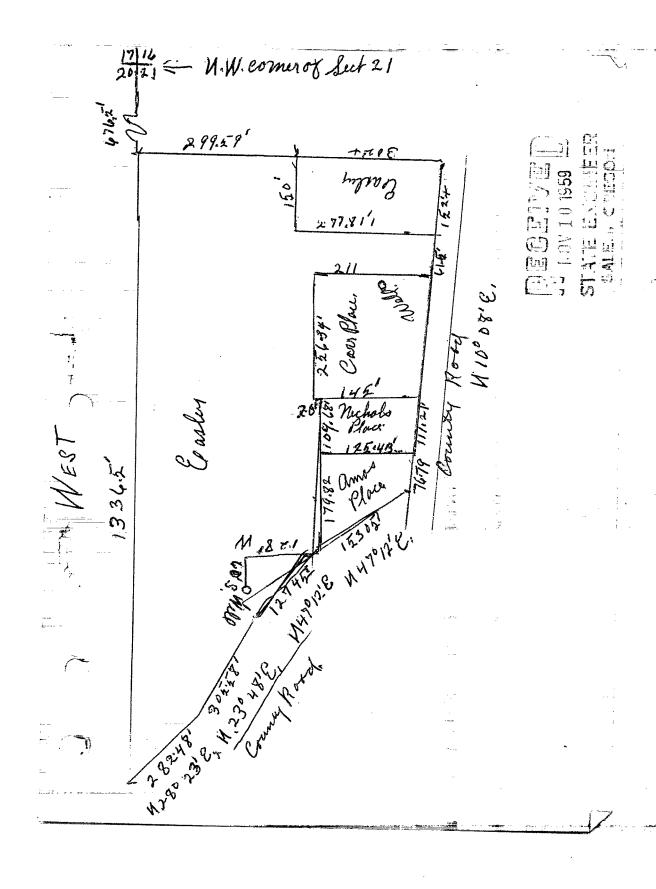

7 Beginning at a point on the West Line of Section 21 Townships 2 North Range 32 Said point being 6765' feet South of the North west comes of Section 21 and to being the South west comes of that hack of land conveyed to Walter Thelmore (Imbarger et ux. by Ded recorded in book 192 P 522 of the Deed Kecords of (umatilla County, Oregon, thence South along the sie tion line a distan of 1336, I feet to a point on the west line of said county road no 223 Thence south stong the west right a way line of County 1 ord Ho Is a 3thouse alord the west right anaphing of said country road by the follows courses tolishucers 1 28 23 Earla distance 282.48 feet 1 23° 48 Carla distance = 2.28 feet. North 47.12 Cast adistance of 127.45 feet Mor or fear to the most foulkedly comes of that track I land described in that certin Contract to Raphel & Mucholsel, ux recorded in book 224 Pogg 66 of the said deed records thence North along the West line of said Whichalo track a distance of 289.3 feet to the North west come thereoff theme West along the whilely extension of the Morth line of the

of the said Michols track a distance 20 feet to an Iron pin: Theree North a destance of 25634 feet To an um pin thence East a destancióf 2160 Leet to the West rightaway line of the said. - County Road (No-1223 thenke North 10°08 East · along the rightodway line a distance of 612 feet mon or less to the Southeast come of that hack of land conveyed to William Deasley Hux by Warranty Deed recorded in book 196 Page 322 of the said deed Records; Thence west along the South line of the William & Easley Track of distance of 277.81 feet to the south west corner thereof: thence North along the West line of said Carly track a Intande of 150 feet to the south line of the South line - a distance of 299+59 more of less to the point of beginning. All being East of the Willamette Merdian in The country of Umalily + State of Oregon.