

UMAT
676

Well Record

STATE WELL NO. 2N/32-29 D(1)
COUNTY Umatilla
APPLICATION NO. U-604

OWNER: John E. Korvola


MAILING ADDRESS: Route 2, Box 121, Pendleton, Ore.

LOCATION OF WELL: Owner's No. 1

CITY AND STATE: Pendleton, Oregon

N.W. 1/4 N.W. 1/4 Sec. 29 T. 2 N. S. R. 32 E. W.M.

Bearing and distance from section or subdivision corner
S 35°10' E 1662 ft. from the NW corner of Sec. 29, T. 2 N., R. 32 E., W.M.

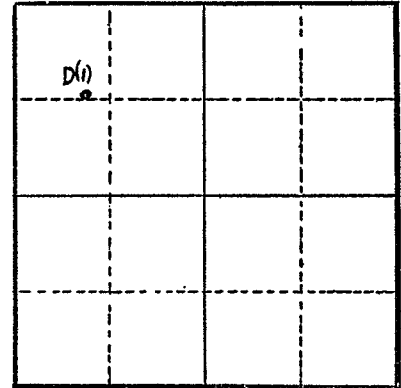

Section 29

Altitude at well

TYPE OF WELL: Drilled Date Constructed May 1953

Depth drilled 280 Depth cased 19 ft. of 12"

CASING RECORD:

FINISH:

AQUIFERS:

WATER LEVEL:

5-53 108 ft;

PUMPING EQUIPMENT: Type Byron Jackson H.P. 40
Capacity 480 G.P.M.

WELL TESTS:

Drawdown	5	ft. after	1/2	hours	465	G.P.M.
Drawdown	15	ft. after	1 1/2	hours	525	G.P.M.

USE OF WATER Irrigation Temp. 58 °F. December 1952, 19

SOURCE OF INFORMATION
DRILLER or DIGGER Leslie I. Turner

ADDITIONAL DATA:

Log Water Level Measurements Chemical Analysis Aquifer Test

REMARKS:

