

STATE ENGINEER
Salem, Oregon

UMAT 86
Well Record

STATE WELL NO. 152-162(1)
COUNTY UMATILLA
APPLICATION NO. _____

U-732

G-6430??

OWNER: Wm. Etter


MAILING ADDRESS: _____

LOCATION OF WELL: Owner's No. _____

CITY AND STATE: _____

NE 1/4 SW 1/4 Sec. 16 T. 1 S. R. 32 E., W.M.

Bearing and distance from section or subdivision corner _____

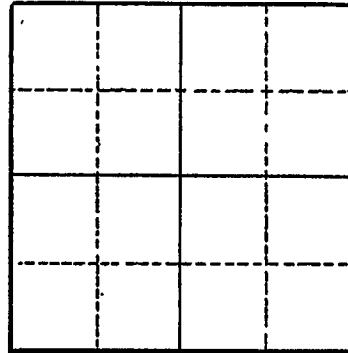

Section _____

Altitude at well _____

TYPE OF WELL: drilled Date Constructed _____

Depth drilled 265' Depth cased _____

CASING RECORD:

6"

FINISH:

AQUIFERS:

BASALT

WATER LEVEL:

15' reported

PUMPING EQUIPMENT: Type TURBINE H.P. _____

Capacity 150 G.P.M.

WELL TESTS:

Drawdown _____ ft. after _____ hours _____ G.P.M.

Drawdown _____ ft. after _____ hours _____ G.P.M.

USE OF WATER Domestic, stock, irrigation Temp. _____ °F. _____, 19 _____

SOURCE OF INFORMATION USGS Report P.M.

DRILLER or DIGGER _____

ADDITIONAL DATA:

Log Water Level Measurements _____ Chemical Analysis _____ Aquifer Test _____

REMARKS:

Test pumped for 1hr at 150gpm with 101 ft of drawdown; supplies irrigation water for 30 acres; see table 2 for log.

UMAT 86

Application No. U-732
 Permit No. U-646
 Well No. 1

REPORT ON COMPLETION OF WELL

(Note: This report should be submitted to the State Engineer, Salem, Oregon, as soon as possible after the well is completed. If more than one well is covered by this permit, a separate report shall be filed for each)

Date of Report _____, 19__

1. Location of well: SW Quarter of Section 16 Twp. 15 Rge. 32 E W. M.
2. Name of nearest natural surface stream East Birch Creek
3. Distance from well to that stream: 1420 feet.
4. If the well is less than 1300 feet from a natural surface stream, give the difference in elevation between the ground surface at the well and the lowest point in stream channel: _____ feet.
5. Date of beginning drilling or digging: April 21, 1951
6. Date well was completed May 12, 1951

7. LOG OF MATERIALS ENCOUNTERED

Character of Material	Depth at which encountered	Thickness of stratum
<u>Dug Well</u>	At surface	<u>0-31</u> ft.
<u>Cement gravel & boulders</u>	<u>31</u> ft.	<u>62</u> ft.
<u>Broken brown basalt cemented</u>	<u>62</u> ft.	<u>78</u> ft.
<u>Hard gray basalt</u>	<u>78</u> ft.	<u>89</u> ft.
<u>Broken brown basalt</u>	<u>89</u> ft.	<u>106</u> ft.
<u>Brown & red basalt</u>	<u>106</u> ft.	<u>125</u> ft.
<u>Black basalt</u>	<u>125</u> ft.	<u>185</u> ft.
<u>Broken brown basalt</u>	<u>185</u> ft.	<u>241</u> ft.
<u>Broken black basalt</u>	<u>241</u> ft.	<u>265</u> ft.

Remarks: _____

WELL INFORMATION

8. Diameter of well 6 inches. Depth of well 265 feet.
9. Depth at which water was first encountered 125 feet.
10. Water level when completed: 15 feet below ground surface.
11. Additional information regarding well; such as soil conditions, quick sand, caves, obstructions, rock, etc.: No large flow of water was encountered while drilling. Slight trace of Mercury in drillings.

UMAT 86

PUMP INFORMATION

12. Manufacturer of pump: Berkley Pump Co
13. Address: _____
14. Data on name or base plate: _____
-
15. Data on pump bowl assembly: _____
Unknown
-
16. Size of pump: 3" x 3/4" Inter Column + shaft.
17. Rated capacity: 150 gallons per minute.
18. Rated speed: 1750 revolutions per minute.
19. Number of stages: 13
20. Size of intake pipe: 3 inch
21. Size of discharge pipe: 2 1/2 inches
22. Length of intake pipe: 145 feet
23. Length of discharge pipe: 550 feet
24. Suction lift: (difference in elevation between water surface in well and pump) 19 feet (static level)
25. Discharge lift: (difference in elevation between pump and end of discharge line) 65 feet
26. Depth of pump intake below ground surface: 150 feet.
27. Remarks: _____
-

MOTOR OR ENGINE INFORMATION

28. Name of manufacturer: U. S. Electric
29. Address: Milford, Conn & Los Angeles, Calif
30. Type of motor or engine: 15 HP 1750 RPM 220/440 Volt
3φ VHS U.S. Motor Los Angeles Type SC 11
31. Data on name or base plate: _____
20 Amps - 440V 40 Amps - 220V 15 HP 3φ
-
32. Rated horsepower: 15
33. Rated speed of motor or engine: 1750 1800 revolutions per minute.
-
34. Rated Capacity of Pump (with described motor)
- | | |
|----------------------|---------------------|
| <u>150</u> g.p.m. at | <u>120</u> ft. head |
| _____ g.p.m. at | _____ ft. head |
| _____ g.p.m. at | _____ ft. head |
| _____ g.p.m. at | _____ ft. head |
| _____ g.p.m. at | _____ ft. head |
-
35. Remarks: _____
-

UMAT 86

CAPACITY TEST

36. Date of test: 10-28-53 & 10-29-1953 37. Temperature of water 50 °F. or ____ °C.
 38. Motor speed during test: 700 RPM to 2800 RPM
 39. Test made by (weir, tank or other means): TANK

Pounds pressure	TOTAL HEAD	*Total lift in feet	Gallons per min.	°Feet to water level	Draw-down	+Time
lbs., Gauge at pump	Total	27 ft. in.	30	27 ft.	8 ft.	5:10 P.M.
lbs., Gauge at pump	Total	34 ft. in.	45	34 ft.	15 ft.	5:20 P.M.
lbs., Gauge at pump	Total	39 ft. in.	60	39 ft.	20 ft.	5:30 P.M.
lbs., Gauge at pump	Total	69 ft. in.	75	69 ft.	50 ft.	8:50 P.M.
lbs., Gauge at pump	Total	110 ft. in.	90	110 ft.	89 ft.	11:45 A.M.
lbs., Gauge at pump	Total	120 ft. in.	120	120 ft.	101 ft.	12:45 A.M.
lbs., Gauge at pump	Total	100 ft. in.	100 90	100 ft.	79 ft.	1:15 P.M.
lbs., Gauge at pump	Total	80 ft. in.	75	80 ft.	59 ft.	1:45 P.M.
lbs., Gauge at pump	Total	75 ft. in.	60	75 ft.	54 ft.	2:25 P.M.
lbs., Gauge at pump	Total	ft. in.		ft.	ft.	M.
lbs., Gauge at pump	Total	ft. in.		ft.	ft.	M.
No pressure
9 to 12 K500

- * Difference in elevation between water level in well and outlet of pump test line.
- ° Distance from ground level to water surface in well.
- ▣ Distance water level is lowered during time interval.
- + Hour and minute at which observation was made.

41. Installation will work efficiently under normal head of 120 ft.
 42. Water is discharged into: Buried 4 inch steel line
 43. Was water lowered to pump intake by test? No
 44. Remarks: at 120 gpm well held steady at 120' pumping level

GENERAL INFORMATION

45. Name of contractor or other party who drilled or dug well: D.K. Smith
 Address: 1013 N. Clinton, Walla Walla, Wash.
 46. Pump and motor were installed by: Carroll Equipment Co
 Address: Pendleton, Oregon
 47. Capacity test was made by: Carroll Equipment Co.
 Address: Pendleton, Ore.
 48. General remarks: _____