

STATE ENGINEER  
Salem, Oregon

UMAT  
910

# Well Record

STATE WELL NO. 2N/33-8G(1)  
COUNTY Umatilla  
APPLICATION NO. U- 751

OWNER: Henry P. Shafer


MAILING ADDRESS: Box 271

LOCATION OF WELL: Owner's No.

CITY AND STATE: Pendleton, Oregon

SW 1/4 NE 1/4 Sec. 8 T. 2 N. 33 E. W.M.

Bearing and distance from section or subdivision corner N.52°19'58"E. 1025.9' from center of sec. 8

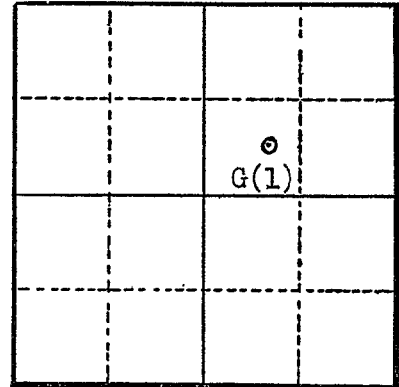

Section 8

Altitude at well

TYPE OF WELL: Drilled Date Constructed

Depth drilled 200' Depth cased

CASING RECORD:

8 inch

FINISH:

AQUIFERS:

WATER LEVEL:

Flowing

PUMPING EQUIPMENT: Type Turbine H.P. 5  
Capacity 80 G.P.M.

WELL TESTS:

Drawdown 17 ft. after 24 hours 80 G.P.M.

Drawdown ft. after hours G.P.M.

USE OF WATER Irrigation Temp. °F., 19

SOURCE OF INFORMATION U- 668

DRILLER or DIGGER Bert Gladney

ADDITIONAL DATA:

Log NA Water Level Measurements Chemical Analysis Aquifer Test

REMARKS:

Bedrock at 20'

