
## The original and first copy of this report are to be filed with the

STATE ENGINEER, SALEM, OREGON TO STATE ENGINEER, SALEM, OREGON STATE ENGINEER, SALEM, OREGON SALEM OF OREGON (Do not write above this line)

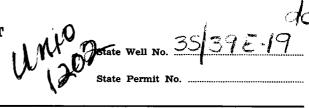

(1) OWNER:	(10) LOCATION OF WELL:
Name Richard Conklin	County UNION Driller's well number
Address Cb Ve DYE	JW 45E 4 Section 19 T. 35 R. 39 E W.M.
(2) TYPE OF WORK (check):	Bearing and distance from section or subdivision corner
	Approx. 100 E. pt NW cornex
New Well Deepening Reconditioning Abandon If abandonment, describe material and procedure in Item 12.	of 200 ve
	(11) WATER LEVEL: Completed well.
(3) TYPE OF WELL: (4) PROPOSED USE (check):	Depth at which water was first found 75 ft.
Rotary Driven Domestic Industrial Municipal Domestic	Static level // ft. below land surface. Date
Dug	Artesian pressure lbs. per square inch. Date
CASING INSTALLED: Threaded Welded To the Diam from the to To ft. Gage 12.5	(12) WELL LOG: Diameter of well below casing
" Diam. fromft. toft. Gage	Depth drilled ft. Depth of completed well ft.
	Formation: Describe color, texture, grain size and structure of materials; and show thickness and nature of each stratum and aquifer penetrated,
PERFORATIONS: Perforated? Yes   No.	with at least one entry for each change of formation. Report each change in position of Static Water Level and indicate principal water-bearing strata.
Type of perforator used FACTORY PERF.	MATERIAL From To SWL
Size of perforations / in. by 3 in.	Tussuil
1600 perforations from 80 ft. to 128 ft.	Clay prown study 5 75
16.50 perforations from 16.5 ft. to 2.70 ft.	Itud, claystrecks 15/20
4000 perforations from 240 ft. to 340 ft.	Clay blue, sendyctoks 120 180
(7) SCREENS: Well screen installed?   Yes   No	Send coarse 160 183
	C/24 8/ve (83 190)
Manufacturer's Name	Sand sometime grave 1902/9
Diam. Slot size Set from ft. to ft.	Clay D/ve Fande 2/8 242
Diam. Slot size Set from ft. to ft.	Orna corre Vinegrave 242,348
	C/ag 1/10e 178 1/80
(8) WELL TESTS: Drawdown is amount water level is lowered below static level	
Was a pump test made?  Yes No If yes, by whom?	
Yield: gal./min. with ft. drawdown after hrs.	
n " " "	
Bailer test / 60 gal./min. with 20 ft. drawdown after 6 hrs.	
Artesian flow g.p.m.	
perature of water 50 Depth artesian flow encountered ft.	Work started 6/5 1973 Completed 6/16 1973
(9) CONSTRUCTION:	Date well drilling machine moved off of well 6/25 19 73
Well seal-Material used	Drilling Machine Operator's Certification:
Well sealed from land surface toft.	This well was constructed under my direct supervision.  Materials used and information reported above are true to my
Diameter of well bore to bottom of seal	best knowledge and belief.
Diameter of well bore below sealin.	[Signed] Date 7/5, 19.23
Number of sacks of cement used in well seal 5-Jock Acody wasks	Drilling Machine Operator's License No3
Number of sacks of bentonite used in well seal sacks	Dinning Machine Operator's Intense 110.
Brand name of bentonite	Water Well Contractor's Certification:
Number of pounds of bentonite per 100 gallons	This well was drilled under my jurisdiction and this report is
of waterlbs./100 gals.	true to the best of my knowledge and belief.
Was a drive shoe used?  Yes No Plugs	Name CARIEL ETCDG LAKE JULE (Person, firm or corporation) (Type or print)
	Address Bon 6/3 LIGAANDE, OLG
	000
Method of sealing strata off	[Signed] (Water Well Contractor)
Was well gravel packed? No Size of gravel: 34→	
Gravel placed from 20 ft. to 340 ft.	Contractor's License No. 5/7 Date 7/15 19.23