NOTICE TO WATER WELL CONTRACTOR The original and first copy of this report are to be filed with the


STATE ENGINEER, SALEM, OREGON 97310 within 30 days from the date of well completion.

WATER WELL PREPORT

STATE OF OREGON

(Please type or print)

(Do not write above this line)

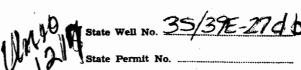

, , , , , , , , , , , , , , , , , , ,		
(1) OWNER:	(10) LOCATION OF WELL:	
Name GOOPER RANCH #2	County UNION Driller's well nur	nber
Address Union Ore.	4/14/	r. 39E w.m.
(2) TYPE OF WORK (check):	Bearing and distance from section or subdivision corner Approx 1300 5. + 40 E. of NWCorne	
New Well Deepening □ Reconditioning □ Abandon □	0f 30 0 Ve	
If abandonment, describe material and procedure in Item 12.		
	(11) WATER LEVEL: Completed well.	
(3) TYPE OF WELL: (4) PROPOSED USE (check):	Depth at which water was first found ft.	
Rotary Driven Domestic Industrial Municipal	Static level ft. below land surface. Date 3//7/74	
Dug ☐ Bored ☐ Irrigation ☑ Test Well ☐ Other ☐	Artesian pressure lbs. per square inch. Date	
CASING INSTALLED: Threaded Welded 25	(12) WELL LOG: Diameter of well below casing / O	
· · · · · · · · · · · · · · · · · · ·	Depth drilled 3 % ft. Depth of completed well 230 ft.	
Ti. to ft. Gage	Formation: Describe color, texture, grain size and structure of materials;	
Ti. Gage ft. Gage	and show thickness and nature of each stratum and aquifer penetrated,	
© PERFORATIONS: Perforated? M Ves. No.	with at least one entry for each change of formati position of Static Water Level and indicate princ	
PERFURATIONS: Perforated? Yes No. Type of perforator used Factory pert.		
1/- 3	MATERIAL	From To SWL
Size of perforations /8 in. by in.	Topsol	0 12
	White ash y soil	1/2 4
perforations from	Brown Clay Blue " sondstreak	76 95
perforations from ft. to ft.		7/2
(7) SCREENS: Well screen installed? Yes No	8/	43 83
Manufacturer's Name	Blue sand, timegravel streaks	60 115
Type Model No	Blue sand + clay streaks	1/5 230
Diam. Slot size Set from ft. to ft.	, , , , , , , , , , , , , , , , , , , ,	230 390
Diam Slot size Set from ft. to ft.		
(8) WELL TESTS: Drawdown is amount water level is lowered below static level		
Was a pump test made? ☐ Yes ☐ No If yes, by whom?		
1: gal./min. with ft. drawdown after hrs.		
" "		
" "		
Baller test / 90 gal./min. with /2 ft. drawdown after 3 hrs.		
tesian flow g.p.m.		
perature of water 54 Depth artesian flow encountered ft.	Work started 5/13 1974 Completed	<u> 5//7 1974</u>
(9) CONSTRUCTION:	Date well drilling machine moved off of well	5//7 1974
Well seal-Material used Cemen	Drilling Machine Operator's Certification:	
Well sealed from land surface to	This well was constructed under my Materials used and information reported a	direct supervision.
Diameter of well bore to bottom of seal in.	best knowledge and belief.	_
Diameter of well bore below sealin.	[Signed] ————————————————————————————————————	
Number of sacks of cement used in well seal 5-52ck MIX sacks	Drilling Machine Operator's License No. 388	
Number of sacks of bentonite used in well seal sacks	Drilling Machine Operator's License No.	
Brand name of bentonite	Water Well Contractor's Certification:	
Number of pounds of bentonite per 100 gallons		
of water lbs./100 gals.	This well was drilled under my jurisdiction and this report is true to the best of my knowledge and belief.	
Was a drive shoe used? ☐ Yes ☐No Plugs Size: location ft.	Name CORRIELL INC (Person, firm or corporation) Address Box 1 3 LAGRANDE, Ore	
Did any strata contain unusable water? Yes No	(Person, firm or corporation) (Type or print)	
Type of water? depth of strata	Address Dox 113 LAGRANDE, Ore	
Method of sealing strata off	[Signed] MPrull	
Was well gravel packed? ✓ Yes ☐ No Size of gravel: 3/4	(Water Well Contra	etor)