

ORIGINAL
File Original, and
Duplicate with the
STATE ENGINEER,
SALEM, OREGON

RECEIVED
DEC 12 1955

WATER WELL DRILLERS REPORT
STATE OF OREGON

Do Not State Well No. 3/40-15N/A
In State Permit No. _____

(1) OWNER:
Name P. C. Curtis
Address Cove, Oregon

Unit 1325

(2) LOCATION OF WELL:
County Union Owner's number, if any—
R. F. D. or Street No.
Bearing and distance from section or subdivision corner
Sec. 15 - Twp 35 - R. 40
well in 1 way on east side.
Com. 24 rods N. of S.W. corner, then 22 rods N. 16 rods
W. 20 rods - 3 1/2 rods less 4 1/2 rods ft. for Methodist Church.

(3) TYPE OF WORK (check):
New well Deepening Reconditioning Abandon
Abandonment, describe material and procedure in Item 11.

(4) PROPOSED USE (check):
Domestic Industrial Municipal
Irrigation Test Well Other

(5) EQUIPMENT:
Rotary
Cable
Dug Well

(6) CASING INSTALLED:
Threaded Welded
FROM 0 ft. to 23 1/2 ft. 6 Diam. 1/2" Gage or Wall
" 17 " 68 " 4 " 1/2" "
" " " " " " "
" " " " " " "
" " " " " " "
" " " " " " "
Type and size of shoe or well ring
Describe joint

If gravel packed
Diameter of Bore from ft. to ft.
Size of gravel:

(7) PERFORATIONS:
Type of perforator used
SIZE of perforations None in., length, by in.
FROM ft. to ft. perf per foot No. of rows
" " " " " " "
" " " " " " "
" " " " " " "
" " " " " " "

SCREENS: None
Give Manufacturer's Name, Model No. and Size


CONSTRUCTION:
Was a surface sanitary seal provided? Yes No To what depth 2 ft.
Were any strata sealed against pollution? Yes No
If yes, note depth of strata
FROM ft. to ft.
" " " "

METHOD OF SEALING Bentonite 10 to 24 ft.

(9) WATER LEVELS:
Depth at which water was first found 67-69 ft.
Standing level before perforating _____ ft.
Standing level after perforating _____ ft.
Log Accepted by:
[Signed] P. C. Curtis Dated 12-7, 1955
Owner

(10) WELL TESTS:
Was a pump test made? Yes No If yes, by whom?
Yield: gal./min. with ft. draw down after hrs.
" " " " "
" " " " "
Artesian flow _____ g.p.m.
Shut-in pressure _____ lbs. per square inch.
Bailer test 15 g.p.m. with negligible drawdown
Temperature of water 47 Was a chemical analysis made? Yes No
Was electric log made of well? Yes No

(11) WELL LOG:
Diameter of well, 6 & 4 inches.
Total depth 69 ft. Depth of completed well 69 ft.
Formation: Describe by color, character, size of material and structure, and show thickness of aquifers and the kind and nature of the material in each stratum penetrated, with at least one entry for each change of formation.
0 ft. to 7 ft. Topsoil, small boulders
7 " 56 " Brown clay, large boulders
56 " 65 " Brown clay, gravel
65 " 67 " Hard sandy clay
67 " 69 " Medium fine sand, water

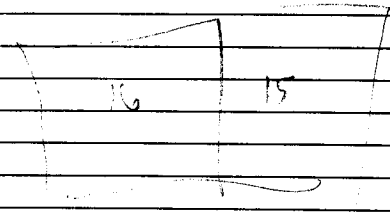

Ground elevation at well site 2900 feet above mean sea level.
Work started Aug 24 1955 Completed Sept. 24 1955

Well Driller's Statement:
This well was drilled under my jurisdiction and this report is true to the best of my knowledge and belief.

NAME Corriell's
(Person, firm, or corporation) (Typed or printed)
Address Box 249, LaGrande, Ore.
Driller's well number 107
[Signed] J. Corriell (Well Driller)
License No. 660 Dated 12-3-55, 19____