

STATE ENGINEER
Salem, Oregon

*Union
1449*

Well Record

STATE WELL NO. *4/39-24H1*
COUNTY *Union*
APPLICATION NO. *6*

OWNER: *Lloyd A. Belle Deger*


MAILING ADDRESS: _____

LOCATION OF WELL: Owner's No. _____

CITY AND STATE: *Union Oregon*

SE 1/4 *NE* 1/4 Sec. *24* T. *4* S., R. *29* E., W.M.

Bearing and distance from section or subdivision corner _____

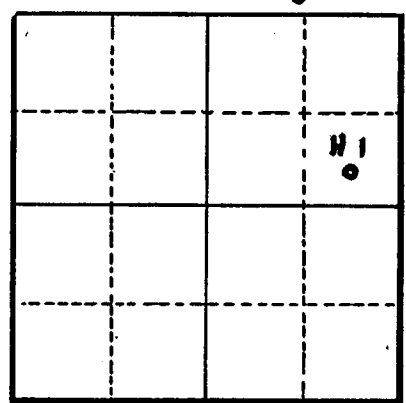

Section *24*

Altitude at well _____

TYPE OF WELL: *Dug* Date Constructed _____

Depth drilled *20* Depth cased *20*

CASING RECORD:

Wood cribbing, 48" diam

FINISH:

AQUIFERS:

WATER LEVEL:

PUMPING EQUIPMENT: Type _____ H.P. *1 1/2*
Capacity _____ G.P.M.

WELL TESTS:
Drawdown _____ ft. after _____ hours _____ G.P.M.
Drawdown _____ ft. after _____ hours _____ G.P.M.

USE OF WATER *Irrigation* Temp. _____ °F. _____, 19.

SOURCE OF INFORMATION *C.226*

DRILLER or DIGGER _____

ADDITIONAL DATA:

Log _____ Water Level Measurements _____ Chemical Analysis _____ Aquifer Test _____

REMARKS: