

STATE ENGINEER
Salem, Oregon

Union 1520 Well Record


STATE WELL NO. *13 J(1)*
COUNTY *UNION*
APPLICATION NO. *47*

OWNER: *James Newman* MAILING ADDRESS: _____

LOCATION OF WELL: Owner's No. *North Well* CITY AND STATE: *North Powder*

NE 1/4 SE 1/4 Sec. *13* T. *6 N.* S., R. *38 W.*, W.M.

Bearing and distance from section or subdivision corner *330' N. and 200' W. of SE 1/4*
~~from section~~ *SE corner of NE 1/4*
SE 1/4, Section 13.

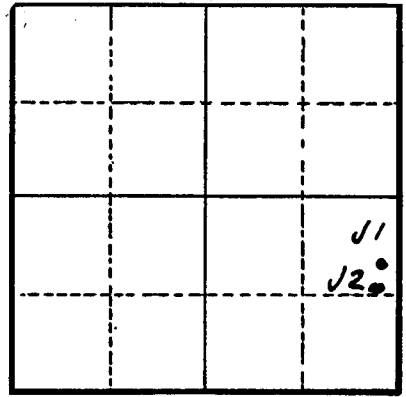

Section *13*

Altitude at well _____

TYPE OF WELL: _____ Date Constructed _____

Depth drilled _____ Depth cased _____

CASING RECORD:

FINISH:

AQUIFERS:

WATER LEVEL:

PUMPING EQUIPMENT: Type _____ H.P. _____
Capacity _____ G.P.M.

WELL TESTS:
Drawdown _____ ft. after _____ hours _____ G.P.M.
Drawdown _____ ft. after _____ hours _____ G.P.M.

USE OF WATER *Irrigation* Temp. _____ °F. _____, 19_____

SOURCE OF INFORMATION _____

DRILLER or DIGGER _____

ADDITIONAL DATA:
Log _____ Water Level Measurements _____ Chemical Analysis _____ Aquifer Test _____

REMARKS: