

STATE ENGINEER
Salem, Oregon

Union
1521

Well Record


STATE WELL NO. 6/38-13J(2)
COUNTY UNION
APPLICATION NO. U-1

OWNER: James Newman MAILING ADDRESS: _____

LOCATION OF WELL: Owner's No. South well CITY AND STATE: North Powder

NE 1/4 SE 1/4 Sec. 13 T. 6 N. S., R. 38 E. W.M.

Bearing and distance from section or subdivision corner 208' W and 100' N. of SE corner of NE 1/4, section 13

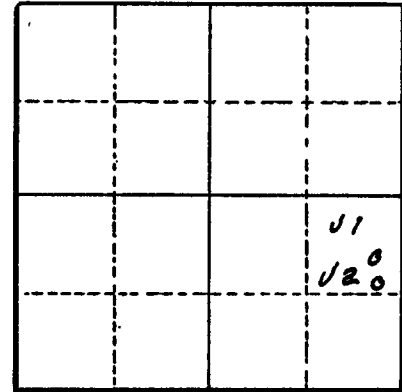

Section _____

Altitude at well _____

TYPE OF WELL: _____ Date Constructed _____

Depth drilled _____ Depth cased _____

CASING RECORD:

FINISH:

AQUIFERS:

WATER LEVEL:

PUMPING EQUIPMENT: Type _____ H.P. _____
Capacity _____ G.P.M.

WELL TESTS:
Drawdown _____ ft. after _____ hours _____ G.P.M.
Drawdown _____ ft. after _____ hours _____ G.P.M.

USE OF WATER Irrigation Temp. _____ °F. _____, 19_____

SOURCE OF INFORMATION _____

DRILLER or DIGGER _____

ADDITIONAL DATA:

Log _____ Water Level Measurements _____ Chemical Analysis _____ Aquifer Test _____

REMARKS: