

STATE ENGINEER
Salem, Oregon

W 1910
1543

Well Record

STATE WELL NO. 6/39-22G
COUNTY Union
APPLICATION NO. GR-2945

OWNER: City of North Powder


MAILING ADDRESS:

LOCATION OF WELL: Owner's No. 2

CITY AND STATE: North Powder, Oregon

SW 1/4 NE 1/4 Sec. 22 T. 6 N. S. R. 39 E. W., W.M.

Bearing and distance from section or subdivision corner 435 ft. E. and 422 ft. N.

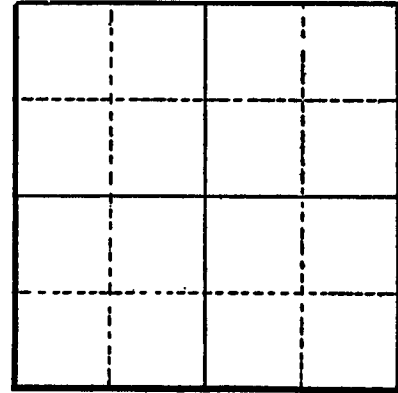

Section

Altitude at well

TYPE OF WELL: Drilled Date Constructed 1915

Depth drilled 300 feet Depth cased 300 feet

CASING RECORD:

6-inch

FINISH:

AQUIFERS:

WATER LEVEL:

2 feet

PUMPING EQUIPMENT: Type Fairbanks-Morse Centrifugal H.P. 10
Capacity 700 G.P.M.

WELL TESTS:

Drawdown ft. after hours Pumping 700 G.P.M.

Drawdown ft. after hours G.P.M.

USE OF WATER Municipal Temp. °F., 19

SOURCE OF INFORMATION GR-2899

DRILLER or DIGGER Ed Ledbetter

ADDITIONAL DATA:

Log Water Level Measurements Chemical Analysis Aquifer Test

REMARKS: