

STATE ENGINEER  
Salem, Oregon

*U.M. 1547*

# Well Record

STATE WELL NO. 6/39-30M  
COUNTY Union  
~~APPLICATION NO.~~ GR-2637

OWNER: Guy Smith, Jr.


MAILING ADDRESS: \_\_\_\_\_

LOCATION OF WELL: Owner's No. \_\_\_\_\_

CITY AND STATE: North Powder, Oregon

NW 1/4 SW 1/4 Sec. 30 T. 6 S., R. 39 E., W.M.

Bearing and distance from section or subdivision corner 1412' N & 38' E from SW corner Sec 30

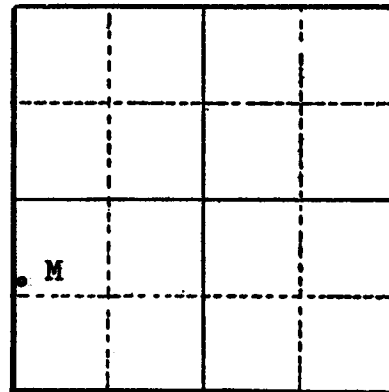

Section 30

Altitude at well 3300'

TYPE OF WELL: Drilled Date Constructed 1908

Depth drilled 766' Depth cased \_\_\_\_\_

### CASING RECORD:

8-inch

### FINISH:

### AQUIFERS:

### WATER LEVEL:

55'

PUMPING EQUIPMENT: Type submersible H.P. 3  
Capacity 30 G.P.M.

### WELL TESTS:

Drawdown 60 ft. after \_\_\_\_\_ hours 400 G.P.M.  
Drawdown \_\_\_\_\_ ft. after \_\_\_\_\_ hours \_\_\_\_\_ G.P.M.

USE OF WATER Irrigation Temp. \_\_\_\_\_ °F. \_\_\_\_\_, 19\_\_\_\_

SOURCE OF INFORMATION GR-3998

DRILLER or DIGGER Blake Kochensparger Deceased

### ADDITIONAL DATA:

Log NA Water Level Measurements \_\_\_\_\_ Chemical Analysis \_\_\_\_\_ Aquifer Test \_\_\_\_\_

### REMARKS: