

STATE ENGINEER
Salem, Oregon

UN10 1709
Well Record

STATE WELL NO. 1N/39-10x
COUNTY Union
APPLICATION NO. G1104

OWNER: Ernest E. Adams


MAILING ADDRESS: Elgin Oregon

LOCATION OF WELL: Owner's No.

CITY AND STATE:

N.W. 1/4 SE 1/4 Sec. 10 T. 1 N. S. R. 29 E. W., W.M.

Bearing and distance from section or subdivision corner N 62° 45' E - 3624 feet from SW corner Section 10

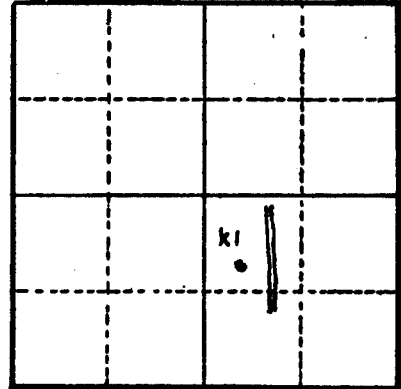

Section 10

Altitude at well

TYPE OF WELL: Drilled Date Constructed

Depth drilled 658 Depth cased

CASING RECORD:

6 inch

FINISH:

AQUIFERS:

WATER LEVEL:

Flows

PUMPING EQUIPMENT: Type H.P.

Capacity G.P.M.

WELL TESTS:

Drawdown ft. after hours G.P.M.

Drawdown ft. after hours G.P.M.

USE OF WATER Irr. Temp. °F., 19

SOURCE OF INFORMATION Obs. G1104

DRILLER or DIGGER

ADDITIONAL DATA:

Log Water Level Measurements Chemical Analysis Aquifer Test

REMARKS:

Owner ordered to repair "leaking condition" 5-19-59

UNIO 1709

For Official Use Only by The Oregon Water Resources Department:

Received Date:

Well Log Number:

Well Identification Tag #:

UNIO 1709

L90661

APPLICATION FOR A WELL IDENTIFICATION TAG

Please print clearly. If shared well see instructions. This is Well # ____ of ____ wells on the property.

LANDOWNER INFORMATION:

Current landowner's name and mailing address:

Rodney & Gail Chaffee, 1117 N.E. Mt. Ash Rd.
Prineville, OR 97754

Mail tag and paperwork to: (Real Estate Co. or other party, if not the current landowner):

Becky Keeling, REMAX Real Estate Team, 2106 Island Ave.
La Grande, OR 97850

Application submitted by (& phone number or e-mail): Becky Keeling 541-963-1000
Owner at time the well was drilled (if known): _____

WELL LOCATION INFORMATION: (May also be referred to as the "Map & Tax Lot")

Township #: 1N (North or South?) Range #: 39 (East or West?) Section #: 10D
Tax Lot #: 600 (generally a 3 or 4 digit number following the Township, Range and Section numbers)
County Union Street Address & City of Well Palmer Junction Rd
Elgin

If the property had a different street address in the past, please indicate it, if known:

WELL INFORMATION: (You do not need to complete this section if the well report is attached)

Type of Well (i.e.; domestic, irrigation, commercial, industrial, monitoring, etc.): _____

Date Well Constructed: _____ Well Depth: _____ Casing Diameter: _____

Other Information: _____

Applications can be mailed to: Oregon Water Resources Department - 725 Summer Street N.E., Suite A - Salem, OR 97301-1271 OR fax to 503-986-0902. Applications are processed and tags mailed every Monday morning. Thank you for participating in Oregon's Well Identification Program!

(revised 6/05)

RECEIVED

MAY 04 2007

WATER RESOURCES DEPT
SALEM OREGON