

RECEIVED

UNID 208
Page 1 of 4

15/39E-20cl

STATE OF OREGON
WATER WELL REPORT
(as required by ORS 537.765)

JAN 26 1988

(1) OWNER:
Name City of Imbler
Address P. O. Box 40, or City Hall
City Imbler State OR Zip 97841

(2) TYPE OF WORK:
 New Well Deepen Recondition Abandon

(3) DRILL METHOD:
 Rotary Air Rotary Mud Cable Other
Rotary Mud 0 - 700 ft.
Reverse Rotary Air 700 - 1,546

(4) PROPOSED USE:
 Domestic Community Industrial Irrigation
 Thermal Injection Other

(5) BORE HOLE CONSTRUCTION:
Depth of Completed Well 1,546 ft.
Special Standards date of approval

| HOLE meter | From | To | SEAL | | Amount sacks or pounds |
|---------------|------|------|----------|----|---------------------------|
| | | | Material | To | |
| 21" | 0 | 36 | Cement | 6 | 409 sacks |
| 19" | 36 | 690 | Cement | 36 | |
| 12 1/2" | 690 | 1546 | | | |

How was seal placed? Method A B C D E
 Other
Backfill placed from _____ ft. to _____ ft. Material _____
Gravel placed from _____ ft. to _____ ft. Size of gravel _____

(6) CASING/LINER:

| Diameter | From | To | Gauge | Steel | | | |
|-------------------------|------|------|-------|-------------------------------------|--------------------------|-------------------------------------|--------------------------|
| | | | | Plastic | Welded | Threaded | |
| Casing: 16" | +1 | 690 | .375 | <input checked="" type="checkbox"/> | <input type="checkbox"/> | <input checked="" type="checkbox"/> | <input type="checkbox"/> |
| Liner: 16x12 K-Packer @ | 655' | | | <input checked="" type="checkbox"/> | <input type="checkbox"/> | <input checked="" type="checkbox"/> | <input type="checkbox"/> |
| 12" | 657 | 677 | .375" | <input checked="" type="checkbox"/> | <input type="checkbox"/> | <input checked="" type="checkbox"/> | <input type="checkbox"/> |
| 10" | 677 | 1546 | .250 | <input checked="" type="checkbox"/> | <input type="checkbox"/> | <input checked="" type="checkbox"/> | <input type="checkbox"/> |

location of shoe(s)

(7) PERFORATIONS/SCREENS:

Perforations Method Manufactured
 Screens Type _____ Material _____

| From | To | Slot size | Number | Diameter | Tele/pipe size | Casing | Liner |
|------|------|-----------|--------|----------|----------------|--------------------------|-------------------------------------|
| 1240 | 1545 | 1/4"x3" | 30 per | foot | | <input type="checkbox"/> | <input checked="" type="checkbox"/> |

(8) WELL TESTS: Minimum testing time is 1 hour
 Pump Bailor Air Flowing Artesian
Yield gal/min Pumping level Drill stem at Time
2500 gpm _____ 1 hr

Temperature of water 78-80°F Depth Artesian Flow Found _____
Was a water analysis done? Yes By whom _____
Did any strata contain water not suitable for intended use? Too little
 Salty Muddy Odor Colored Other _____
Depth of strata: 36-49 & 276-282

(9) LOCATION OF WELL by legal description:
County Union Latitude 45°27'28" Longitude 117°57'45"
Township 1S N or S, Range 39E E or W, WM.
Section 20 SE 1/4 of SW 1/4
Tax Lot 3300 Lot 2 Block 24 Subdivision Imbler
Street Address of Well (or nearest address) on Esther Street
west of City Hall

(10) STATIC WATER LEVEL:
_____ ft. below land surface. Date _____
Artesian pressure 38 lb. per square inch. Date 12/12/87

(11) WELL LOG: Ground elevation 2725

| Material | From | To | WB? | SWL |
|---|------|----|-----|-----|
| See attached sheets for formations, list of water bearing zones, drilling summary, and a well diagram. | | | | |
| NOTE: The well is 26' deeper than indicated by the formation log. 26' error made between 700' depth and 1,546'. | | | | |

Date started 7/28/87 Completed 12/11/87

(unbonded) Water Well Constructor Certification:
I constructed this well in compliance with Oregon well construction standards. Materials used and information reported above are true to my best knowledge and belief.
Signed Wally Lowe Date 12/12/87
Wally Lowe, Driller

(bonded) Water Well Constructor Certification:
I accept responsibility for construction of this well and its compliance with all Oregon water well standards. This report is true to the best of my knowledge and belief.
Signed Shawn Brown Date 1-18-87
Company Brown & Brown Drilling Co. Job No. _____

UN10208

RECEIVED

JAN 25 1988

FORMATIONS

WATER RESOURCES DEPT.
SALEM, OREGON

| <u>Material</u> | <u>From</u> | <u>To</u> |
|--|-------------|-----------|
| Silt | 0 | 2 |
| Sand | 2 | 36 |
| Sand and Clay Tan | 36 | 49 |
| Clay - Green | 49 | 175 |
| Clay - Gray | 175 | 225 |
| Clay - Sandy | 175 | 229 |
| Clay - Brown | 229 | 276 |
| Sand - Water Bearing | 276 | 282 |
| Clay - Green and Sandy | 282 | 318 |
| Clay - Green | 318 | 408 |
| Black Basalt | 412 | 470 |
| Gray Basalt | 470 | 532 |
| Red Cinders | 532 | 549 |
| Clay - Gray - Broken Rock | 549 | 613 |
| Clay - Green and Brown | 613 | 638 |
| Basalt - Black | 638 | 706 |
| Basalt - Gray | 706 | 729 |
| Basalt - Gray Fractured with Red Clay Cinders | 729 | 734 |
| Basalt Fractured - Green Clay | 734 | 823 |
| Red Clay | 823 | 834 |
| Basalt Green Clay | 834 | 845 |
| Clay - Tan | 845 | 848 |
| Clay - Green | 848 | 856 |
| Basalt - Black | 856 | 876 |
| Red Clay | 876 | 877 |
| Black Basalt - Green Clay | 877 | 934 |
| Green Clay | 934 | 947 |
| Fractured Basalt with some Clay | 947 | 1,020* |
| Basalt - Gray | *1,056 | 1,076 |
| Clay - Green | 1,076 | 1,091 |
| Basalt Black/Clay | 1,091 | 1,170 |
| Red Cinders and Clay - Green and Gray | 1,170 | 1,187 |
| Basalt - Black | 1,187 | 1,281 |
| Red Cinders and Clay - Green | 1,281 | 1,305 |
| Basalt - Black | 1,305 | 1,310 |
| Basalt - Gray | 1,310 | 1,330 |
| Red Cinders and Clay | 1,330 | 1,335 |
| Basalt - Vesicular | 1,335 | 1,343 |
| Basalt - Fractured, loose | 1,343 | 1,380 |
| Red Cinders and Green Clay | 1,380 | 1,391 |
| Basalt - Black | 1,391 | 1,410 |
| Red Cinders and Green Clay | 1,410 | 1,413 |
| Basalt - Gray | 1,413 | 1,461 |
| Basalt - Vesicular and Red Cinders | 1,461 | 1,471 |
| Basalt - Black | 1,471 | 1,495 |
| Basalt - Black, Fractured, Loose | 1,495 | 1,506 |
| Basalt - Black | 1,506 | 1,509 |
| Red Cinders and Clay | 1,509 | 1,517 |
| Basalt - Black, Fractured, Loose | 1,517 | 1,520 |

T.

RECEIVED

JAN 25 1988

WATER BEARING ZONESWATER RESOURCES DEPT.
SALEM, OREGON

| <u>Material</u> | <u>From</u> | <u>To</u> | <u>Estimated Artesian Flow</u> |
|---|-------------|-----------|------------------------------------|
| Sandy Clay | 36 | 49 | |
| Sand | 276 | 282 | |
| Fractured Gray Basalt with Red Cinders | 729 | 734 | 50 gpm |
| Red Cinders | 1,170 | 1,178 | 100 gpm |
| Red Cinders | 1,281 | 1,305 | 100 gpm |
| Fractured Basalt | 1,305 | 1,308 | 150 gpm |
| Red Cinders | 1,330 | 1,335 | 100 gpm |
| Fractured Basalt, Loose | 1,343 | 1,380 | 500 gpm |
| Red Cinders | 1,380 | 1,391 | 200 gpm |
| Red Cinders | 1,410 | 1,413 | 100 gpm |
| Vesicular Basalt and Red Cinders | 1,461 | 1,471 | 100 gpm |
| Fractured Basalt, Loose | 1,495 | 1,506 | 500 gpm |
| Red Cinders | 1,509 | 1,517 | 100 gpm |
| Fractured Basalt, Loose | 1,517 | 1,520 | 500 gpm |

NOTE: The Well is 26' deeper than indicated by the formation log.
26' error made between 700' depth and 1,546'.

DRILLING SUMMARY:


Well was drilled to 700 feet using mud. Set 16" casing with float shoe cemented from 690 to ground level.

Drilled air reverse from 700 to bottom at 1,546. Experienced clays caving continuously while drilling.

Decided to sacrifice top 100 gpm of water to shut clay stratas off to prevent clays plugging perforations.

Installed blank 10" casing from 1,250 to 675 with a K-packer on top to seal to 16" casing, 5 formation packers on 10" casing at various depths to ensure sealing to solid drilled hole to shut off caving clay.

Well has 305 feet of perforated 10" liner from 1,240 to 1,545. Well is flowing 2,500 gpm. Temperature is 78 - 80°F at 38 lbs. pressure.

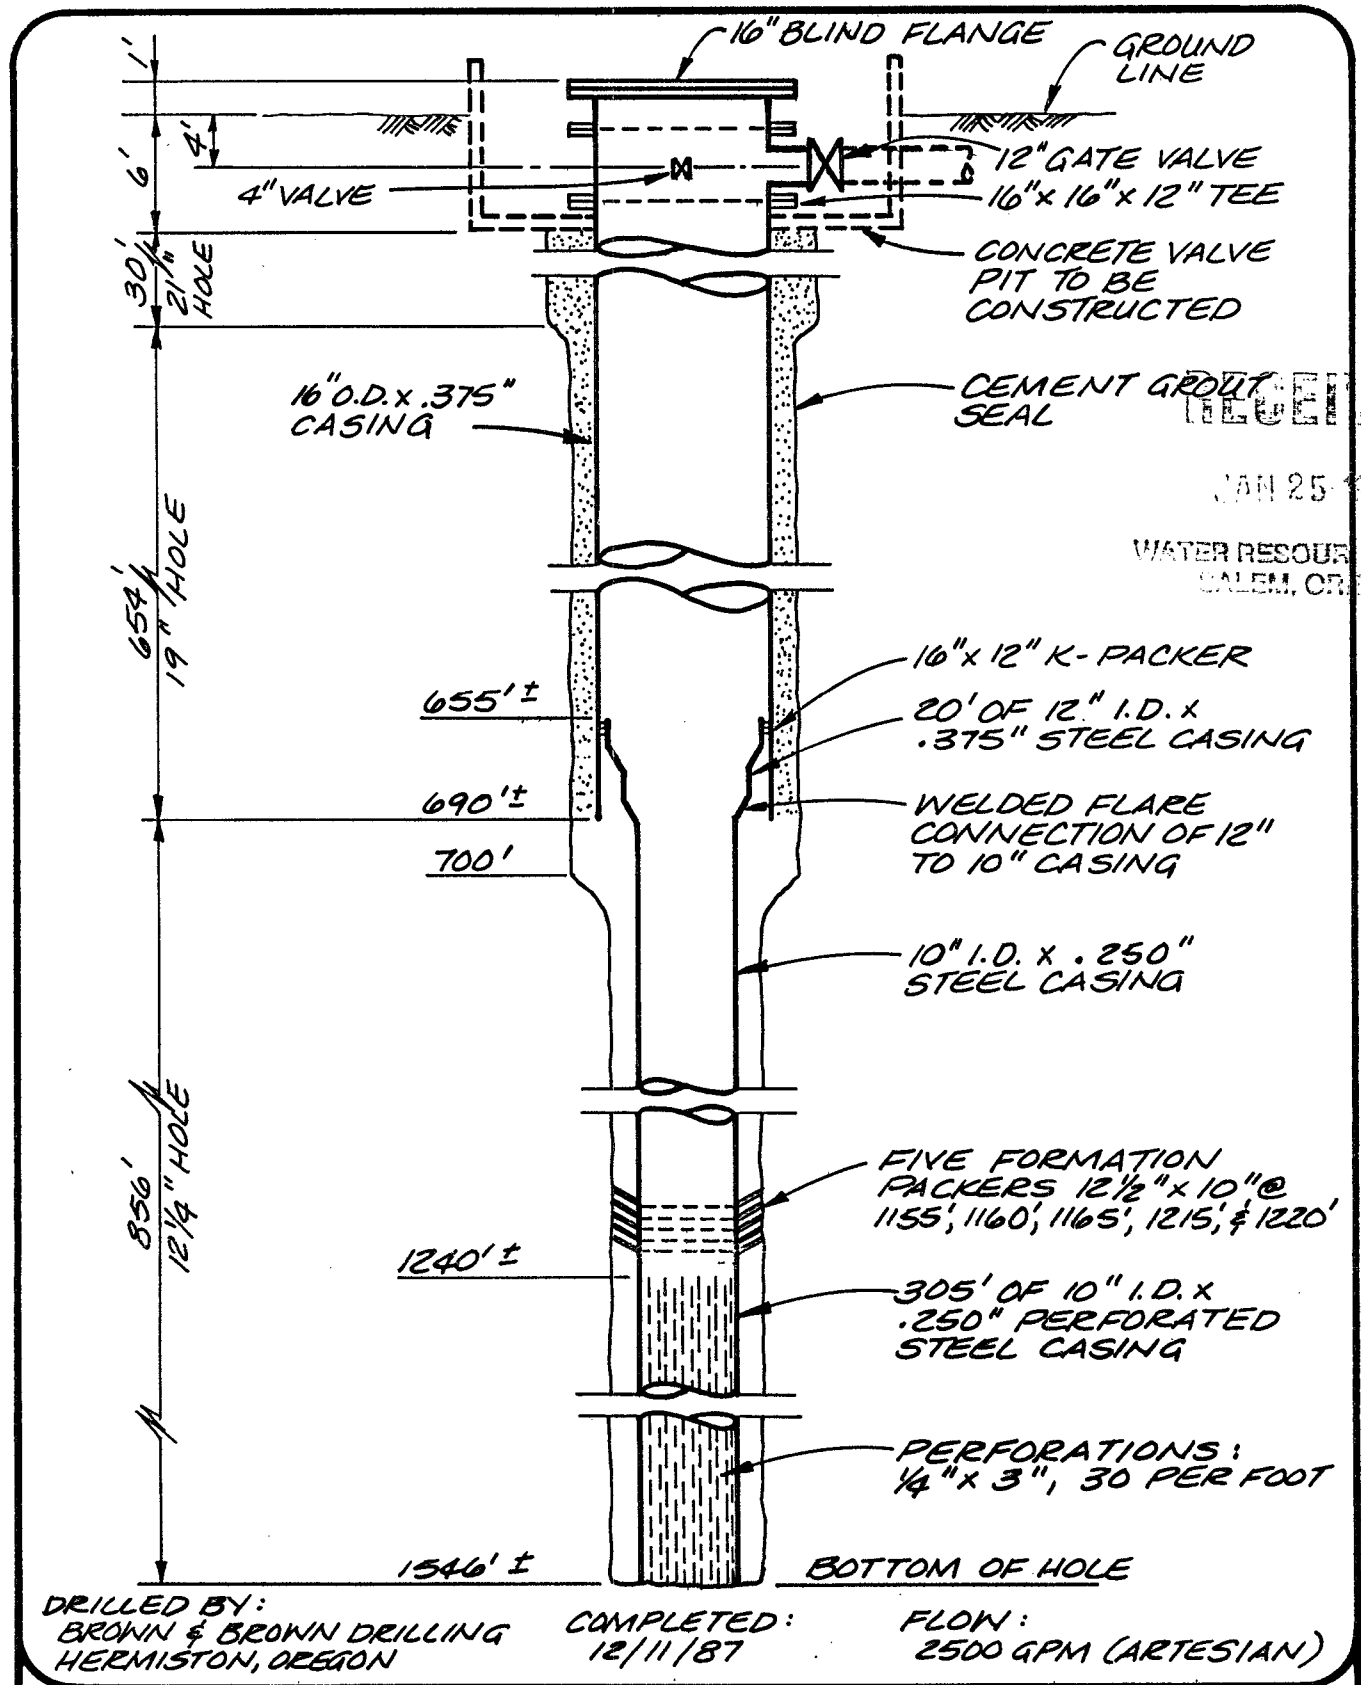


BROWN & BROWN
DRILLING

CITY OF
IMBLER, OREGON
MUNICIPAL WATER SUPPLY WELL

FIGURE

1

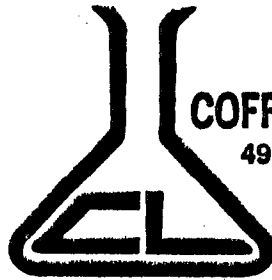

COFFEY LABORATORIES, INC.

4914 N.E. 122nd Ave.
Portland, OR 97230
Phone: (503) 254-1794

RECEIVED
RECEIVED
DEC 30 1987

DEC 25 1988

WATER RESOURCES DEPT.
SALEM, OREGON

Anderson Perry Association
P.O. Box 1107
La Grande, OR 97850
Attention: Jess Holt

December 23, 1987
Log #P871211-F
P.O. #881-20-02

Subject: EPA Inorganic and Oregon Secondary Contaminants Analysis

Sample Collected: 12/09/87
Sample Received: 12/11/87
Collection Point: Imbler Well

| ANALYSIS | METHOD | UNITS | RESULTS | LIMIT |
|-----------|-----------|-------|---------------|----------|
| Arsenic | EPA 206.2 | mg/L | < 0.001 | 0.050 |
| Barium | * | mg/L | < 0.005 | 1.0 |
| Cadmium | EPA 213.2 | mg/L | < 0.001 | 0.010 |
| Calcium | * | mg/L | 2.04 | --- |
| Chloride | EPA 300.0 | mg/L | 1.47 | 250 |
| Chromium | EPA 218.2 | mg/L | < 0.001 | 0.050 |
| Color | EPA 110.2 | C.U. | < 1 | 15 |
| Copper | * | mg/L | < 0.01 | 1.0 |
| Fluorides | EPA 300.0 | mg/L | 1.34 | 1.4-2.4 |
| Hardness | SM 314 | mg/L | 5.16 | 250 |
| Iron | * | mg/L | < 0.010 | 0.3 |
| Lead | EPA 239.2 | mg/L | < 0.001 | 0.050 |
| Magnesium | * | mg/L | 0.017 | --- |
| Manganese | * | mg/L | < 0.005 | 0.05 |
| Mercury | EPA 245.1 | mg/L | < 0.0005 | 0.002 |
| Nitrate | EPA 300.0 | mg/L | < 0.1 | 10.0 |
| Turbidity | SM 207 | --- | None Detected | --- |
| pH | EPA 150.1 | S.U. | 9.21 | 6.5 Min. |
| Sand | EPA 160.2 | mg/L | < 0.5 | 2 |
| Selenium | EPA 270.2 | mg/L | < 0.001 | 0.010 |
| Silver | EPA 272.2 | mg/L | < 0.001 | 0.050 |
| Solids | EPA 160.1 | mg/L | 128 | 500 |
| Sulfate | EPA 300.0 | mg/L | 6.04 | 250 |
| Zinc | * | mg/L | < 0.005 | 5.0 |

The less than "<" symbol means none detected at or above the indicated value and represents the detection limit for the method.

Federal Register, 40 CFR Part 136, Method 200.7, Friday, October 26, 1984, Part VIII

Sincerely,

Susan M. Coffey

Susan M. Coffey
President

JMC/lws

This report is for the sole and exclusive use of the above client. Samples are retained a maximum of 15 days from the date of this letter.