

STATE OF OREGON
WATER WELL REPORT
 (as required by ORS 537.765)

UNIO
 2153

RECEIVED

UNIO
 7

#4895 START CARD
 3S/38E/406

AUG 10 1992

(1) OWNER: LeLand R. Sams Owner's Well Number: _____
 Name LeLand R. Sams
 Address Rt. 3 Box 3482
 City LA GRANDE State ORE. Zip 97150

(2) TYPE OF WORK:
 New Well Deepen Recondition Abandon

(3) DRILL METHOD:
 Rotary Air Rotary Mud Cable Other

(4) PROPOSED USE:
 Domestic Community Industrial Irrigation
 Thermal Injection Other

(5) BORE HOLE CONSTRUCTION:
 Depth of Completed Well 158' ft.
 Special Standards date of approval _____

HOLE			SEAL			Amount sacks or pounds
Diameter	From	To	Material	From	To	
10	0	38		0	38	28
8 1/2	38	100				
8 1/2	100	158				

How was seal placed? Method A B C D E
 Other _____
 Backfill placed from _____ ft. to _____ ft. Material _____
 Gravel placed from _____ ft. to _____ ft. Size of gravel _____

(6) CASING/LINER:

Diameter	From	To	Gauge	Steel	Plastic	Welded	Threaded
Casing: 8 1/2	0+1	100	250	<input checked="" type="checkbox"/>	<input type="checkbox"/>	<input checked="" type="checkbox"/>	<input type="checkbox"/>
Liner: 6"	88	158	250	<input type="checkbox"/>	<input checked="" type="checkbox"/>	<input checked="" type="checkbox"/>	<input type="checkbox"/>

Final location of shoe(s) 99'

(7) PERFORATIONS/SCREENS:
 Perforations Method Power SAW
 Screens Type CLASS 200 Material PVC

From	To	Slot size	Number	Diameter	Tele/pipe size	Casing	Liner
9	158	3/6	4249	6 3/8		<input checked="" type="checkbox"/>	<input type="checkbox"/>

(8) WELL TESTS: Minimum testing time is 1 hour
 Pump Bailer Air Flowing Artesian
 Yield gal/min 90 Pumping level 2. Drill stem at 158 Time 3 hr

Temperature of water 56 Depth Artesian Flow Found _____
 Was a water analysis done? Yes By whom _____
 Did any strata contain water not suitable for intended use? Too little
 Salty Muddy Odor Colored Other _____
 Depth of strata: _____

(9) LOCATION OF WELL by legal description:
 County Union Latitude _____ Longitude _____
 Township 3S N or S, Range 38 E or W, WM.
 Section 4AB 1/4 1/4 1/4
 Tax Lot 600 Lot _____ Block _____ Subdivision _____
 Street Address of Well (or nearest address) Riddle Rd.
MAY PARK

(10) STATIC WATER LEVEL:
26' ft. below land surface. Date 4-19-89
 Artesian pressure _____ lb. per square inch. Date _____

(11) WELL LOG: Ground elevation _____

Material	From	To	WB?	SWL
TOP SOIL	0	1		
CLAY (brown)	1	7		
GRAVEL + CLAY	7	15		
GRAVEL + SAND	15	18	WB	9
GRAVEL + CLAY	18	63		
GRAVEL (hard)	63	76		
GRAVEL + CLAY	76	83		
GRAVEL (small)	83	87	WB	26
GRAVEL + CLAY	87	101		
CLAY + GRAVEL	101	111		
CLAY + SAND	111	115		
GRAVEL	115	119	WB	
GRAVEL + CLAY	119	147		
GRAVEL (small)	147	158	WB	

Date started 4-5-89 Completed 4-19-89

(unbonded) Water Well Constructor Certification:
 I constructed this well in compliance with Oregon well construction standards. Materials used and information reported above are true to my best knowledge and belief.
 Signed _____ Date _____

(bonded) Water Well Constructor Certification:
 I accept responsibility for construction of this well and its compliance with all Oregon water well standards. This report is true to the best of my knowledge and belief.
 Signed Wahls Lowe Date 4-19-89
 Company Lowe Well Drilling Co. Job No. _____


AUG 10 1992

BUILDING DIAGRAM

WATER RESOURCES DIV.
SALEM, OREGON
Drawn By OS
Checked By DS

Date 8-5-84
Date 9/25/90
Date _____

Account No. 35384 ^{AB 500} 1701-1-7
Street Address West Ave. 61921
Year Built 1966

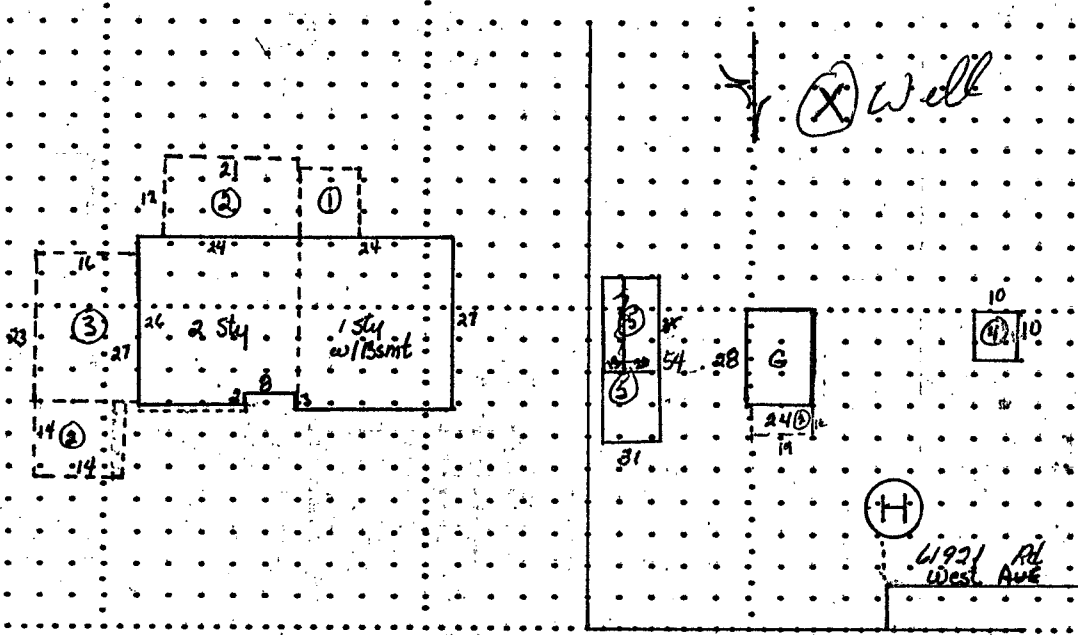

Building Area

- MAIN Floor 1256 #
- 2nd Sty 648 #
- Bsmt 648 #
- GARAGE 672 #
- ① wd. Deck 90 #
- ② Cove. Drive & Patio 664 #
- ③ Carport 368 #
- ④ Pump house 100 #
- ⑤ ~~Archives shed~~ 620 #
Play Cabin 1674 #



RECEIVED

AUG 10 1992

SCALE 1:2400

RECEIVED
MAR 18 1991
DEPT. OF REVENUE STATE OF OREGON
ASSESSMENT & APPRAISAL DIV.

WATER RESOURCES DEPT.
SALEM, OREGON

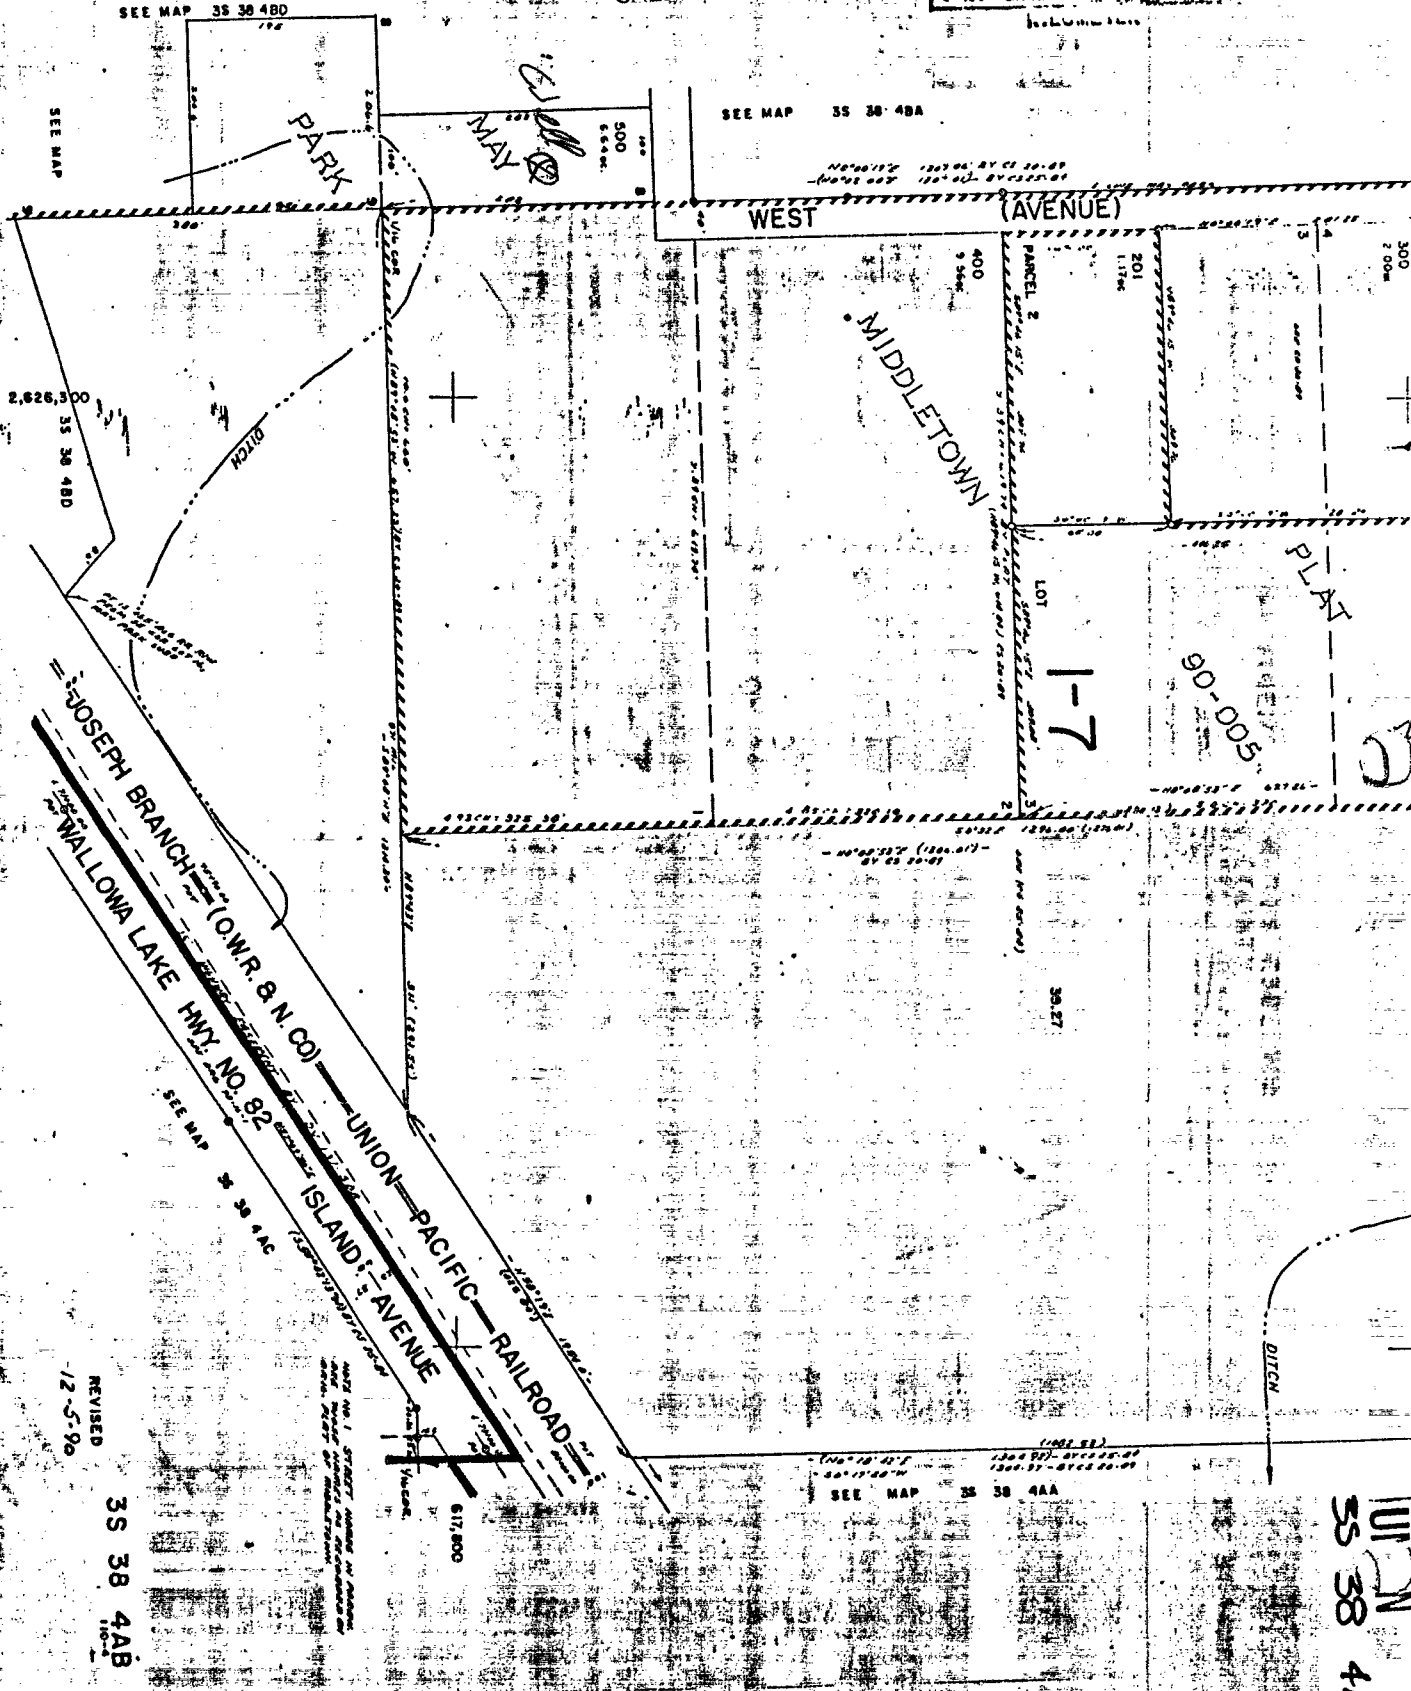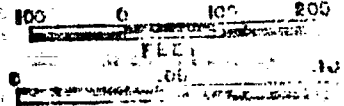

2,626,300
SEE MAP 35 38 4BD

SEE MAP 35 38 4BA

NO. 1017 1267 04 BY CI 10-89
NO. 1017 1267 04 BY CI 10-89

JOSEPH BRANCH (O.W.R. & N. CO.)
WALLOWA LAKE HWY. NO. 82

UNION PACIFIC RAILROAD
ISLAND AVENUE

REVISED
12-5-90

35 38 4AB

SEE MAP 35 38 4AA

UNION
35 38 4AB