

NOTICE TO WATER WELL CONTRACTOR
The original and first copy of this report
are to be filed with the

WATER RESOURCES DEPARTMENT,
SALEM, OREGON 97310
within 30 days from the date
of well completion.

UNION WATER WELL REPORT
UNIO 2390
STATE OF OREGON
(Please type or print)
(Do not write above this line)

65/39E-4dc
~~65/39E-9dc~~
State Well No. _____
State Permit No. _____
Per letter received 5-19-80 see file for job for letter

(1) OWNER:

Name Riversport & Rade
Address Baker, Oregon

(2) TYPE OF WORK (check):

New Well Deepening Reconditioning Abandon
If abandonment, describe material and procedure in Item 12.

(3) TYPE OF WELL:

Rotary Driven
Cable Jetted
 Bored

(4) PROPOSED USE (check):

Domestic Industrial Municipal
Irrigation Test Well Other

(5) CASING INSTALLED:

16" Diam. from 1 1/2 ft. to 18 1/2 ft. Gage 250
" Diam. from _____ ft. to _____ ft. Gage _____
" Diam. from _____ ft. to _____ ft. Gage _____

(6) PERFORATIONS:

Perforated? Yes No.

Type of perforator used _____
Size of perforations in. by in.
_____ perforations from _____ ft. to _____ ft.
_____ perforations from _____ ft. to _____ ft.
_____ perforations from _____ ft. to _____ ft.

(7) SCREENS:

Well screen installed? Yes No

Manufacturer's Name _____ Model No. _____
Type _____ Diam. _____ Slot size _____ Set from _____ ft. to _____ ft.
Diam. _____ Slot size _____ Set from _____ ft. to _____ ft.

(8) WELL TESTS:

Drawdown is amount water level is lowered below static level

Was a pump test made? Yes No If yes, by whom?
" 500 gal./min. with 180 ft. drawdown after 2 hrs.
" Compressor test " " "
" " " " "
Bailer test gal./min. with ft. drawdown after hrs.
Artesian flow g.p.m.
Temperature of water 63° Depth artesian flow encountered _____ ft.

(9) CONSTRUCTION:

Well seal—Material used Cement Grout
Well sealed from land surface to 30 ft.
Diameter of well bore to bottom of seal 20 in.
Diameter of well bore below seal 6 in.
Number of sacks of cement used in well seal 40 sacks
How was cement grout placed? Pumped into casing and forced up around casing with water and kept under pressure.
Was a drive shoe used? Yes No Plugs 6" Size: location 30 ft.
Did any strata contain unusable water? Yes No
Type of water? _____ depth of strata _____
Method of sealing strata off _____
Was well gravel packed? Yes No Size of gravel: _____
Gravel placed from _____ ft. to _____ ft.

(10) LOCATION OF WELL:

County Baker Driller's well number 79K15
SW 1/4 SE 1/4 Section 9 T. 65 R. 39E W.M.
Bearing and distance from section or subdivision corner
SW 1/4 SE 1/4 Sec. 9 T. 65 R. 39E

(11) WATER LEVEL: Completed well.

Depth at which water was first found 205 ft.
Static level 40 ft. below land surface. Date 11/9/79
Artesian pressure lbs. per square inch. Date _____

(12) WELL LOG:

Diameter of well below casing 6"
Depth drilled 500 ft. Depth of completed well 20 ft.

Formation: Describe color, texture, grain size and structure of materials; and show thickness and nature of each stratum and aquifer penetrated, with at least one entry for each change of formation. Report each change in position of Static Water Level and indicate principal water-bearing strata.

MATERIAL	From	To	SWL
TOP Soil	0	2	
Yellow Clay	2	5	
Yellow Clay + Coarse Sand	5	10	
Brown Clay + Small gravel	10	30	
Black Basalt	30	205	
Brown, Fractured Basalt	205	211	40
Brown Basalt, Solid	211	345	
Black Basalt	345	500	

RECEIVED

JAN 16 1980

WATER RESOURCES DEPT.
SALEM, OREGON

Work started 10/4 19 79 Completed 10/31 19 79
Date well drilling machine moved off of well 10/31 19 79

Drilling Machine Operator's Certification:

This well was constructed under my direct supervision. Materials used and information reported above are true to my best knowledge and belief.
[Signed] Kell M. Thompson Date 11/9, 1979
(Drilling Machine Operator)
Drilling Machine Operator's License No. 1382

Water Well Contractor's Certification:

This well was drilled under my jurisdiction and this report is true to the best of my knowledge and belief.
Name Ube Drilling, Inc.
(Person, firm or corporation) (Type or print)
Address Prine City, Oregon
[Signed] Bond Jobe
(Water Well Contractor)
Contractor's License No. 582 Date 19 Nov, 1979

UNIO 2390

Jobe Drilling, Inc.

STAR ROUTE - PRAIRIE CITY, OREGON 97869 - (503) 820-3346

17 May 1980

RECEIVED
MAY 19 1980

Water Resources Department
Mill Creek Office Park
555 13th Street N.E.
Salem, Oregon

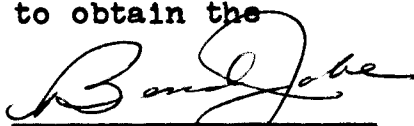
Re: Error and Correction
of Well Site

A test well for Rufenacht and Rode Cattle Co. was drilled and completed on the 31st of Oct. 1979. The drillers well number was 79K15. The location of the well is in error.

The location read Baker County, Sw $\frac{1}{4}$ of Se $\frac{1}{4}$, Sec 9, T. 6S and R. 39E. It should read Union County, Sw $\frac{1}{4}$ of Se $\frac{1}{4}$, Sec 4, T. 6S and R. 39E.

The Well has since been developed and the well report with the correct location accompanies this letter.

The well report was held up to obtain the well test report.


Bond Jobe
Jobe Drilling, Inc.