

STATE ENGINEER
Salem, Oregon

UNNO
587

Well Record

STATE WELL NO. 2/38-33G
COUNTY Union
APPLICATION NO. GR-3162

OWNER: Robert J. Chandler


MAILING ADDRESS: Route 1, Box 216

LOCATION OF WELL: Owner's No.

CITY AND STATE: La Grande, Oregon

SW 1/4 NE 1/4 Sec. 33 T. 2 N. S., R. 38 E. W.M.

Bearing and distance from section or subdivision corner 960' E. and 1000' N.

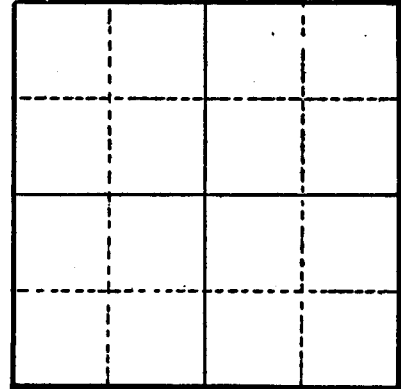

Section

Altitude at well

TYPE OF WELL: Dug Date Constructed 1923

Depth drilled 14' Depth cased 10'

CASING RECORD:

48"	Concrete tube	from	14	to	10'
"	"	"	"	10	" 6'
"	"	"	"	6	" 2'
"	"	"	"	2	" top of ground

FINISH:

AQUIFERS:

soil, gravel

WATER LEVEL:

9 1/2'

PUMPING EQUIPMENT: Type Parma Submerged #3 H.P. 10
Capacity 800 G.P.M.

WELL TESTS:

Drawdown	3	ft. after	hours	pumping 500	G.P.M.
Drawdown		ft. after	hours		G.P.M.

USE OF WATER Irrigation Temp. °F. , 19

SOURCE OF INFORMATION GR-2960

DRILLER or DIGGER

ADDITIONAL DATA:

Log Water Level Measurements Chemical Analysis Aquifer Test

REMARKS:

heavy black soil	7	7
loose round gravel, water bearing all thru gravel	7	7