

STATE ENGINEER
Salem, Oregon

UN10
588

Well Record

GR- 1470

STATE WELL NO. 2/38-33G
COUNTY Union
APPLICATION NO. GR-1523

OWNER: Claude T. Dougherty

MAILING

ADDRESS: Rt. 1, Box 217

LOCATION OF WELL: Owner's No.


CITY AND

STATE: La Grande, Oregon

SW 1/4 NE 1/4 Sec. 33 T. 2 S. R. 38 E. W.M.

Bearing and distance from section or subdivision

corner 420' E. & 533.5' N. from Center Sec. 33

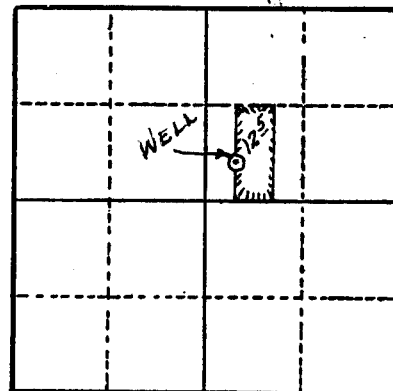

Section 33

Altitude at well 2700'

TYPE OF WELL: Dug Date Constructed 1926

Depth drilled 18' Depth cased 18'

CASING RECORD:

36" concrete

FINISH:

Perforated with 3 or 4 holes, 3 or 4 in. in diameter from 12 to 18 ft.

AQUIFERS:

WATER LEVEL:

10'

PUMPING EQUIPMENT: Type 6" Idaho lift H.P. 5

Capacity 270 G.P.M.

WELL TESTS:

Drawdown ft. after hours G.P.M.

Drawdown ft. after hours G.P.M.

USE OF WATER Irrigation Temp. °F. 19

SOURCE OF INFORMATION GR Record

DRILLER or DIGGER James Clay

ADDITIONAL DATA:

Log N.A. Water Level Measurements Chemical Analysis Aquifer Test

REMARKS:

Irrigation of 12.5 acres.