

STATE ENGINEER
Salem, Oregon

Well Record

STATE WELL NO. 2/38-33G1
COUNTY UNION
APPLICATION NO.

OWNER: Clyde C. Jones

MAILING
ADDRESS:

LOCATION OF WELL: Owner's No.

CITY AND
STATE:

1/4 1/4 Sec. T. N. E.
S., R. W., W.M.


Bearing and distance from section or subdivision

corner

Altitude at well 2,756

TYPE OF WELL: Dug Date Constructed

Depth drilled 12 Depth cased

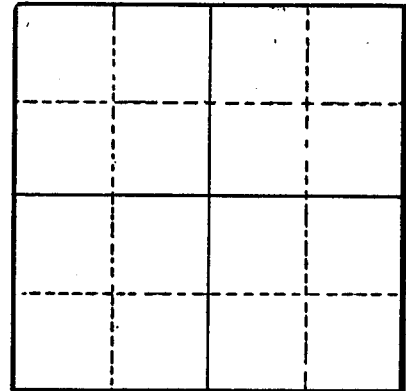

Section

CASING RECORD:

72X inch
96 inch

FINISH:

AQUIFERS:

WATER LEVEL:

4 feet below land surface, 1953

PUMPING EQUIPMENT: Type Centrifugal H.P.
Capacity 180 G.P.M.

WELL TESTS:

Drawdown ft. after hours G.P.M.
Drawdown ft. after hours G.P.M.

USE OF WATER Irrigation Temp. °F., 19

SOURCE OF INFORMATION USGS

DRILLER or DIGGER

ADDITIONAL DATA:

Log Water Level Measurements Chemical Analysis Aquifer Test

REMARKS:

Irrigated 2 acres, July to Sept. 1953