

STATE ENGINEER
Salem, Oregon

*4010
601*

Well Record

STATE WELL NO. 2/38-33N1
COUNTY UNION
APPLICATION NO.

OWNER: C. E. Primm


MAILING ADDRESS:

LOCATION OF WELL: Owner's No.

CITY AND STATE:

..... 1/4 1/4 Sec. T. N. E.
S., R. W., W.M.

Bearing and distance from section or subdivision corner

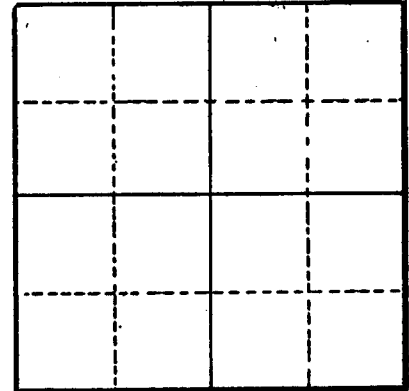

Section

Altitude at well 2,763

TYPE OF WELL: Dug Date Constructed

Depth drilled 12 Depth cased

CASING RECORD:

84x inch
84 inch

FINISH:

AQUIFERS:

Gravel from 5 to 12

WATER LEVEL:

8 feet below land surface, 1930

PUMPING EQUIPMENT: Type None H.P.
Capacity G.P.M.

WELL TESTS:

Drawdown ft. after hours G.P.M.
Drawdown ft. after hours G.P.M.

USE OF WATER None Temp. °F., 19.....

SOURCE OF INFORMATION USGS

DRILLER or DIGGER

ADDITIONAL DATA:

Log Water Level Measurements Chemical Analysis Aquifer Test

REMARKS:

Pumped 400 gpm for 6 hours, drawdown 3 ft.
Aquifer overlain by soil. Pumped "dry" in August, 1952.