

STATE ENGINEER  
Salem, Oregon

Unit  
765  
Unit  
765

# Well Record

STATE WELL NO. 3/38-3B1  
COUNTY UNION  
APPLICATION NO.

OWNER: R. Goodnough MAILING ADDRESS:

LOCATION OF WELL: Owner's No. CITY AND STATE:


1/4 1/4 Sec. T. N. E. S, R. W., W.M.

Bearing and distance from section or subdivision corner

Altitude at well 2.736

TYPE OF WELL: Dug Date Constructed

Depth drilled 25 Depth cased

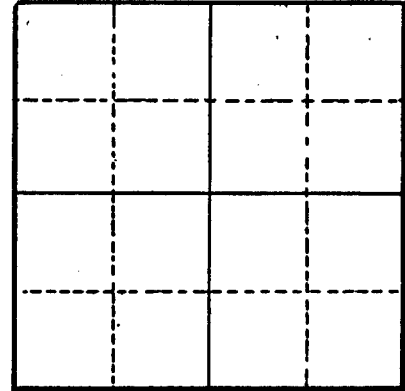

Section

### CASING RECORD:

8 inch

### FINISH:

### AQUIFERS:

Gravel from 4 to 20

### WATER LEVEL:

6 feet below land surface, March, 1934

PUMPING EQUIPMENT: Type Piston H.P.  
Capacity G.P.M.

### WELL TESTS:

Drawdown ft. after hours G.P.M.  
Drawdown ft. after hours G.P.M.

USE OF WATER Irrigation Temp. °F., 19

SOURCE OF INFORMATION USGS

DRILLER or DIGGER

### ADDITIONAL DATA:

Log Water Level Measurements Chemical Analysis Aquifer Test

### REMARKS:

Irrigates 3 acres. Pumped 300 gpm for 1 hr., drawdown 20 ft.