

STATE ENGINEER  
Salem, Oregon

Unit 857  
Union 857

# Well Record


STATE WELL NO. 3/38-4F  
COUNTY Union  
APPLICATION NO. GR-4230

OWNER: Ariel S. Bean MAILING ADDRESS: RFD 1, Box 363

LOCATION OF WELL: Owner's No. CITY AND STATE: La Grande, Oregon

WELL = 1  
SE 1/4 NW 1/4 Sec. 4 T. 3 S, R. 38 E, W.M.

Bearing and distance from section or subdivision  
corner 385' N. & 9' E. of SW Cor. Lot 11  
May Park Addition

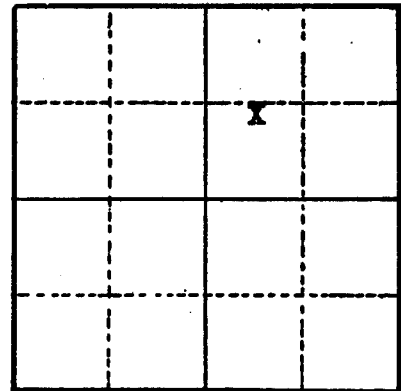

Altitude at well

TYPE OF WELL: dug Date Constructed prior 1927

Depth drilled 7 ft. \* Depth cased 7 ft. Section 4  
\* These depths are at the well in old river channel. Add 8 ft. for height of adjacent land.

### CASING RECORD:

cased with 2 inch planks to 7 feet

### FINISH:

### AQUIFERS:

### WATER LEVEL:

4 feet below surface\*

PUMPING EQUIPMENT: Type Idaho lift type 6 in. discharge H.P.  
Capacity 400 G.P.M.

### WELL TESTS:

Drawdown ft. after hours G.P.M.  
Drawdown ft. after hours G.P.M.

USE OF WATER Irrigation Temp. °F., 19

SOURCE OF INFORMATION Well Registration Statement Cert. # GR-3769

DRILLER or DIGGER

### ADDITIONAL DATA:

Log X Water Level Measurements Chemical Analysis Aquifer Test

### REMARKS:

Log: well 385' N. & 9' E. -- river gravel with some dirt mixed in Thickness 7 Depth to Bottom 7