

STATE ENGINEER  
Salem, Oregon

*Unit 932*  
*Unit 932*

# Well Record

STATE WELL NO. *868-644*  
COUNTY *UNION*  
APPLICATION NO. *G-4823*

OWNER: *CITY OF LA GRANDE*


MAILING ADDRESS:

LOCATION OF WELL: Owner's No. *#1*

CITY AND STATE:

..... 1/4 ..... 1/4 Sec. ..... T. ..... N. S., R. ..... E. W., W.M.

Bearing and distance from section or subdivision corner

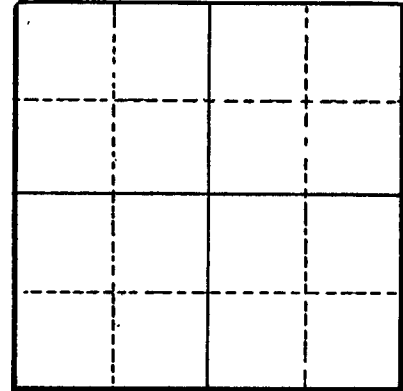

Section .....

Altitude at well *2,790*

TYPE OF WELL: *DRILLED* Date Constructed .....

Depth drilled *1,035* Depth cased .....

CASING RECORD:

*14 INCH*

FINISH:

AQUIFERS:

*BASALT ?*

WATER LEVEL:

*195 FEET BELOW LAND SURFACE, 1925*

PUMPING EQUIPMENT: Type *NONE* H.P. ....  
Capacity ..... G.P.M.

WELL TESTS:

Drawdown ..... ft. after ..... hours ..... G.P.M.

Drawdown ..... ft. after ..... hours ..... G.P.M.

USE OF WATER *PUBLIC SUPPLY* Temp. ..... °F. ...., 19.....

SOURCE OF INFORMATION *U.S.G.S.*

DRILLER or DIGGER .....

ADDITIONAL DATA:

Log ..... Water Level Measurements ..... Chemical Analysis ..... Aquifer Test .....

REMARKS: