

Menam, Oregon
July 21, 1958

O.C. Gandy
North Powder, Ore.
Dear Mr Gandy:

Please find enclosed
directions of well just drilled.

S.W. $\frac{1}{4}$ of the S.W. $\frac{1}{4}$
of Sec. 29. 2N-41 - E.W. in





Sincerely
Myron Fleser
Menam, Oregon

Over.

As this is the only description
I have of this well am sending
it along with map

Respectfully yours

O.C. Tandy

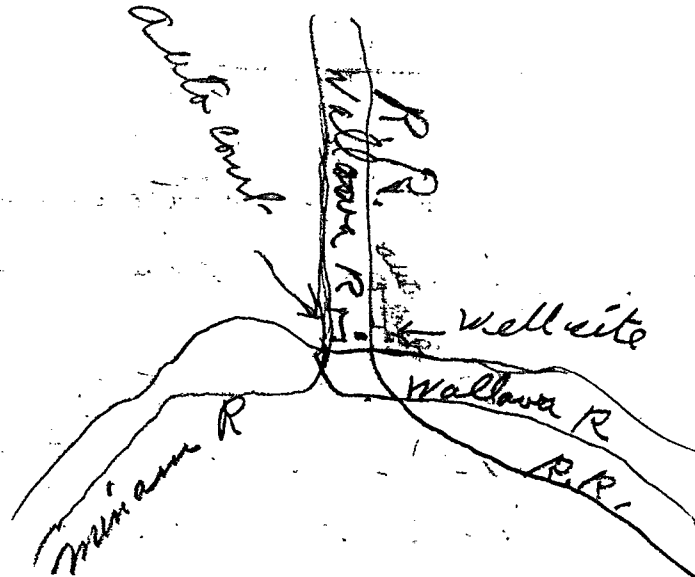

The Well would be about 60 ft N.
from Highway and approx 80 ft W.
from R.R. about 200 ft E. from
south end of auto court.