

STATE OF OREGON
WATER WELL REPORT
 (as required by ORS 537.765)

DEC 06 1989
WASC 2223
 WATER RESOURCES DEPT.
 SALEM, OREGON

IN/12E/1ad

(START CARD) # 15471

(1) OWNER: Well Number: _____
 Name Renato G. B. Vergori
 Address 3755 Sandlin Rd W
 City The Dalles State OR Zip 97058

(2) TYPE OF WORK:
 New Well Deepen Recondition Abandon

(3) DRILL METHOD
 Rotary Air Rotary Mud Cable
 Other _____

(4) PROPOSED USE:
 Domestic Community Industrial Irrigation
 Thermal Injection Other _____

(5) BORE HOLE CONSTRUCTION:
 Special Construction approval Yes No Depth of Completed Well 188 ft.
 Yes No
 Explosives used Type _____ Amount _____

HOLE			SEAL			Amount sacks or pounds
Diameter	From	To	Material	From	To	
10"	0	18	Bentonite	0	18	27 sacks
8"	18	187				

How was seal placed: Method A B C D E
 Other Bentonite poured in 10" hole
 Backfill placed from _____ ft. to _____ ft. around 6" casing
 Gravel placed from 75 ft. to 187 ft. Size of gravel 1/4" minus

(6) CASING/LINER:

Diameter	From	To	Gauge	Material			
				Steel	Plastic	Welded	Threaded
Casing: 6"	+1	188	250	<input checked="" type="checkbox"/>	<input type="checkbox"/>	<input checked="" type="checkbox"/>	<input type="checkbox"/>
Liner:				<input type="checkbox"/>	<input type="checkbox"/>	<input type="checkbox"/>	<input type="checkbox"/>

Final location of shoe(s) 187 ft

(7) PERFORATIONS/SCREENS:
 Perforations Method downdrive
 Screens Type _____ Material _____

From	To	Slot size	Number	Diameter	Tele/pipe size	Casing	Liner
85	160	1/8 x 1	1125	6"	.250	<input checked="" type="checkbox"/>	<input type="checkbox"/>

(8) WELL TESTS: Minimum testing time is 1 hour
 Pump Bailor Air Flowing Artesian
 Yield gal/min approx 50 GPM Drawdown _____ Drill stem at 167 ft Time 1 hr.

Temperature of water 55° Depth Artesian Flow Found _____
 Was a water analysis done? Yes By whom _____
 Did any strata contain water not suitable for intended use? Too little
 Salty Muddy Odor Colored Other _____
 Depth of strata: _____

(9) LOCATION OF WELL by legal description:
 County Wasco Latitude _____ Longitude _____
 Township 1 N N or S, Range 12 E E or W, WM.
 Section 1 SE NE
 Tax Lot _____ Lot _____ Block _____ Subdivision _____
 Street Address of Well (or nearest address) 3755 Sandlin Rd W
The Dalles OR 97058

(10) STATIC WATER LEVEL:
69 ft. below land surface. Date 11-7-89
 Artesian pressure _____ lb. per square inch. Date _____

(11) WATER BEARING ZONES:
 Depth at which water was first found 85

From	To	Estimated Flow Rate	SWL
85	160	50 GPM	69

(12) WELL LOG: Ground elevation approx 1,000

Material	From	To	SWL
Sandstone, brown rocky	0	40	
Sandstone, grey	40	45	
Sandstone, brown	45	85	
Sandstone, brown rocky	85	115	69
Sandstone, grey	115	140	69
Sandstone, brown	140	160	69
Sandstone, brown rocky	160	187	69

Date started Oct 9, 1989 Completed Nov 7, 1989

(unbonded) Water Well Constructor Certification:
 I certify that the work I performed on the construction, alteration, or abandonment of this well is in compliance with Oregon well construction standards. Materials used and information reported above are true to my best knowledge and belief.
 WWC Number _____
 Signed _____ Date _____


(bonded) Water Well Constructor Certification:
 I accept responsibility for the construction, alteration, or abandonment work performed on this well during the construction dates reported above. all work performed during this time is in compliance with Oregon well construction standards. This report is true to the best of my knowledge and belief.
 WWC Number 569
 Signed Silbert Clayton Date 12-3-89

T. 1 N. R. 12 & 13 E. W.M.

RECEIVED

OCT 21 1997

WATER RECCOURCES DEPT.
SALEM, OREGON

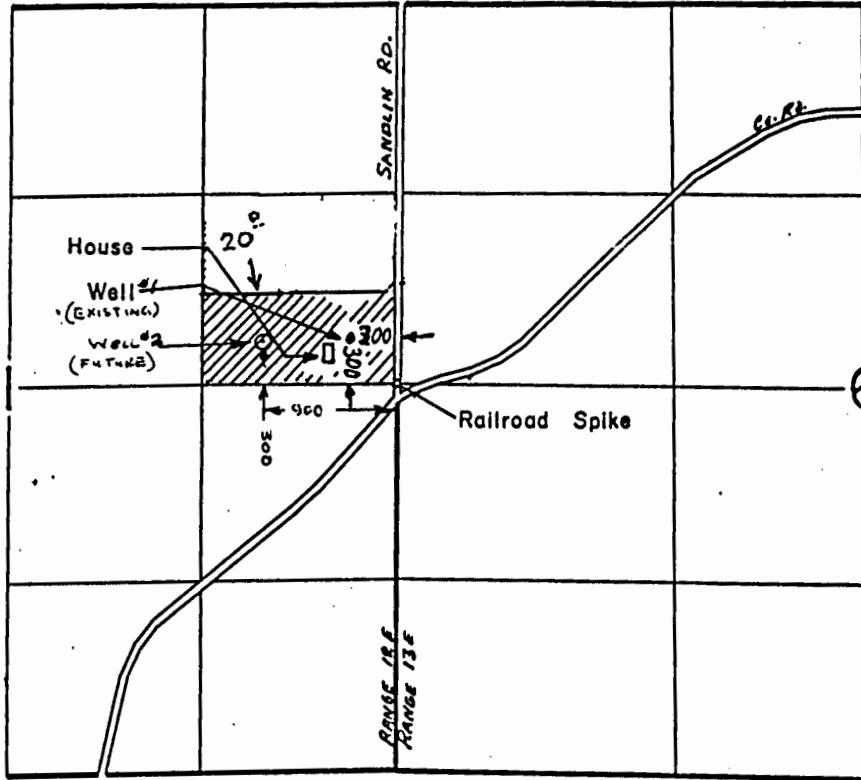

SCALE = 1" = 1320'

Application No. 2-11215 Permit No. G10847
IN NAME OF

RENATO G.B. VERGORI

Surveyed JUNE 1987, by DENNIS KRAMER