

STATE ENGINEER
Salem, Oregon

WASCO OBSERVATION WELL
Well Record

STATE WELL NO. 1N/12-13Q(1)
COUNTY Wasco
APPLICATION NO. G-170

002306

OWNER: Kenneth Kortge


MAILING ADDRESS:

LOCATION OF WELL: Owner's No.

CITY AND STATE:

SW 1/4 SE 1/4 Sec. 13 T. 1 N R. 12 E W.M.

Bearing and distance from section or subdivision corner

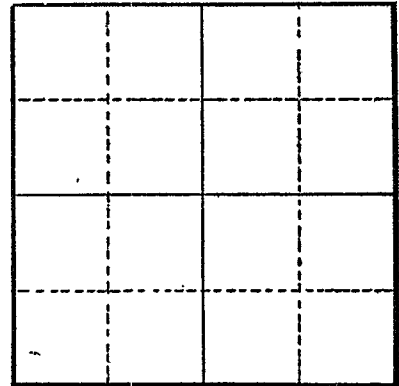

Section 13

Altitude at well 492.7

TYPE OF WELL: drilled Date Constructed 1955

Depth drilled 580 Depth cased 270

CASING RECORD:

8-inch, set from 0 to 270 feet, cemented into basalt

FINISH:

8-inch open hole

AQUIFERS:

Basalt

WATER LEVEL: 95 lbs reported

flows - 795 gpm wide open after 1 hour +

PUMPING EQUIPMENT: Type _____ H.P. _____
Capacity _____ G.P.M. _____

WELL TESTS:

Drawdown _____ ft. after _____ hours _____ G.P.M.

Drawdown _____ ft. after _____ hours _____ G.P.M.

USE OF WATER Irrigation Temp. 76 °F., 19

SOURCE OF INFORMATION Well Drillers Report

DRILLER or DIGGER Dorin Wilburn

ADDITIONAL DATA:

Log Water Level Measurements _____ Chemical Analysis _____ Aquifer Test _____

REMARKS:

