

STATE ENGINEER
Salem, Oregon

WASCO Well Record

STATE WELL NO. 1N/12-23 B
COUNTY WASCO
APPLICATION NO. GR-3014

002357

OWNER: Clifford P. Whalen


MAILING
ADDRESS: _____

LOCATION OF WELL: Owner's No. _____

CITY AND
STATE: The Dalles, Ore

NW 1/4 NE 1/4 Sec. 23 T. 1N, R. 12E, W.M.

Bearing and distance from section or subdivision
corner _____

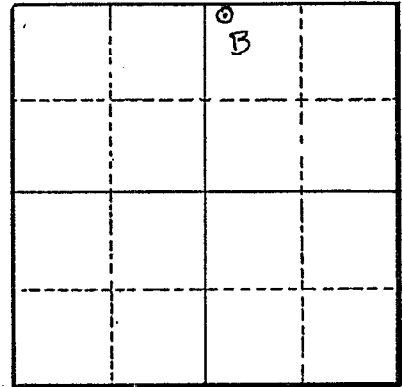

Section 23

Altitude at well _____

TYPE OF WELL: dug Date Constructed 1922

Depth drilled 7' Depth cased _____

CASING RECORD:

FINISH:

AQUIFERS:

WATER LEVEL:

3'

PUMPING EQUIPMENT: Type Myers Pump H.P. 3
Capacity 40 G.P.M.

WELL TESTS:

Drawdown _____ ft. after _____ hours 40 G.P.M.
Drawdown _____ ft. after _____ hours _____ G.P.M.

USE OF WATER Irrigation Temp. _____ °F., 19 _____

SOURCE OF INFORMATION GR-3982

DRILLER or DIGGER _____

ADDITIONAL DATA:

Log NA Water Level Measurements _____ Chemical Analysis _____ Aquifer Test _____

REMARKS: