

STATE ENGINEER
Salem, Oregon

WASCO
002408

**OBSERVATION WELL
Well Record**

STATE WELL NO. 1N/13-1F(1)
COUNTY Wasco
APPLICATION NO. U-186 U-336

OWNER: Threemile Irr. Coop.

MAILING ADDRESS: _____


LOCATION OF WELL: Owner's No. _____

CITY AND STATE: _____

SE $\frac{1}{4}$ NW $\frac{1}{4}$ Sec. 1 T. 1 $\frac{N}{S}$, R. 13 $\frac{E}{W}$, W.M.

Bearing and distance from section or subdivision

corner 2943' N. & 1783' E from SW cor. Sec. 1

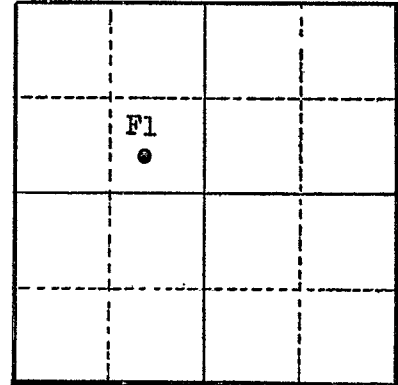

Section 1

Altitude at well 120 ±

TYPE OF WELL: Drilled Date Constructed 1945

Depth drilled 335 Depth cased 32

CASING RECORD:

16 inch set to 32'

FINISH:

Open hole - 12 inch

AQUIFERS:

Basalt

WATER LEVEL:

51½ feet, reported

PUMPING EQUIPMENT: Type Turbine H.P. 100
Capacity _____ G.P.M.

WELL TESTS:

Drawdown very little ft. after _____ hours pumping 1500 G.P.M.

Drawdown _____ ft. after _____ hours _____ G.P.M.

USE OF WATER Irrigation Temp. 50 °F., 19 _____

SOURCE OF INFORMATION U-186

DRILLER or DIGGER _____

ADDITIONAL DATA:

Log Water Level Measurements _____ Chemical Analysis _____ Aquifer Test _____

REMARKS:

