

STATE ENGINEER
Salem, Oregon

WASCO Well Record
002417


STATE WELL NO. 1N/13-3G(4)
COUNTY Wasco
APPLICATION NO. _____

OWNER: George P. & Wilbur Stadelman MAILING ADDRESS: 206 Laughlin St.
(Stadelman Ice Company)

LOCATION OF WELL: Owner's No. #1 CITY AND STATE: The Dalles, Oregon

SW 1/4 NE 1/4 Sec. 3 T. 1 N. 13 E. W, W.M.

Bearing and distance from section or subdivision corner _____

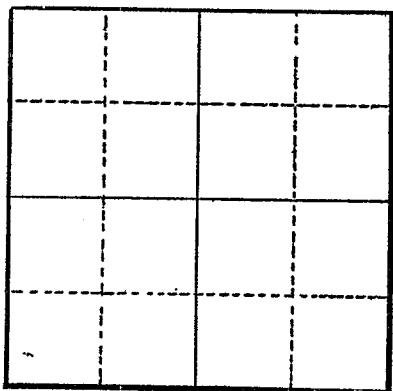

Section 3

Altitude at well 98 ft.

TYPE OF WELL: Drilled Date Constructed 1942

Depth drilled 200 ft. Depth cased 60 ft.

CASING RECORD:
8 inch

FINISH:

AQUIFERS:

WATER LEVEL:
30 ft.

PUMPING EQUIPMENT: Type Deming 5 stage H.P. 7 1/2
Capacity 165 G.P.M.

WELL TESTS:
Drawdown _____ ft. after _____ hours _____ G.P.M.
Drawdown _____ ft. after _____ hours _____ G.P.M.

USE OF WATER Dom. & Industrial Temp. _____ °F. _____, 19____

SOURCE OF INFORMATION Related registration statement

DRILLER or DIGGER _____

ADDITIONAL DATA:
Log _____ Water Level Measurements _____ Chemical Analysis _____ Aquifer Test _____

REMARKS: