

STATE ENGINEER
Salem, Oregon

WASC
002488

OBSERVATION WELL
Well Record

STATE WELL NO. 1N/13-8M(1)
COUNTY Wasco
APPLICATION NO. U-181

OWNER: Mill Creek Irrig. Coop. Inc.

MAILING ADDRESS: Rt. 2

LOCATION OF WELL: Owner's No. _____

CITY AND STATE: The Dalles


NW 1/4 SW 1/4 Sec. 8 T. 1 N. R. 13 E. W.M.

Bearing and distance from section or subdivision corner _____

Altitude at well _____

TYPE OF WELL: drilled Date Constructed 1945

Depth drilled 371 Depth cased _____

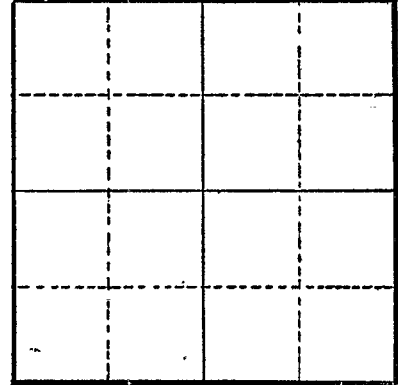

Section 8

CASING RECORD:

12-inch, set to _____.

FINISH:

Open well below casing

AQUIFERS:

Basalt

WATER LEVEL:

249' in 1945

PUMPING EQUIPMENT:

Type Turbine H.P. 75
Capacity _____ G.P.M.

WELL TESTS:

Drawdown 1 ft. after 100 hours pumping 550 G.P.M.
Drawdown _____ ft. after _____ hours _____ G.P.M.

USE OF WATER Irrigation Temp. _____ °F., 19

SOURCE OF INFORMATION U-181

DRILLER or DIGGER Bert Clayton

ADDITIONAL DATA:

Log Water Level Measurements Chemical Analysis _____ Aquifer Test _____

REMARKS: Permit No. U-189, Certificate No. 20790

