

STATE ENGINEER  
Salem, Oregon

**WASC** Well Record  
**002538**


STATE WELL NO. 1N/13-12A(1)  
COUNTY Wasco  
APPLICATION NO. U-28

OWNER: John McClaskey (formerly Fred Cyphe) MAILING ADDRESS: \_\_\_\_\_

LOCATION OF WELL: Owner's No. \_\_\_\_\_ CITY AND STATE: \_\_\_\_\_

NE 1/4 NE 1/4 Sec. 12 T. 1 N. R. 13 W.M.

Bearing and distance from section or subdivision  
corner 1085' S. & 900' W from NE corner Sec. 12.

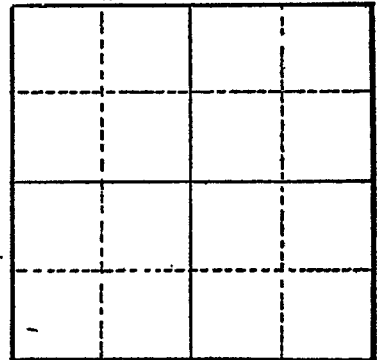

Section 12

Altitude at well \_\_\_\_\_

TYPE OF WELL: drilled Date Constructed 1930

Depth drilled 114 Depth cased \_\_\_\_\_

CASING RECORD:

8-inch  
deepened from 70 to 114 feet in 1938

FINISH:

AQUIFERS:

Basalt

WATER LEVEL:

Flows

PUMPING EQUIPMENT: Type \_\_\_\_\_ H.P. \_\_\_\_\_  
Capacity \_\_\_\_\_ G.P.M.

WELL TESTS:

Drawdown \_\_\_\_\_ ft. after \_\_\_\_\_ hours \_\_\_\_\_ G.P.M.  
Drawdown \_\_\_\_\_ ft. after \_\_\_\_\_ hours \_\_\_\_\_ G.P.M.

USE OF WATER irrigation Temp. \_\_\_\_\_ °F. \_\_\_\_\_, 19\_\_\_\_

SOURCE OF INFORMATION U-28, WSP 659

DRILLER or DIGGER \_\_\_\_\_

ADDITIONAL DATA:

Log  Water Level Measurements \_\_\_\_\_ Chemical Analysis \_\_\_\_\_ Aquifer Test \_\_\_\_\_

REMARKS: Well flowed about 75 g.p.m. in 1930

