

STATE ENGINEER  
Salem, Oregon

**WASC**  
**002539**

# Well Record

STATE WELL NO. 1N/13-12A(2)  
COUNTY Wasco  
APPLICATION NO. \_\_\_\_\_

OWNER: Fred Cypher

MAILING ADDRESS: \_\_\_\_\_

LOCATION OF WELL: Owner's No. \_\_\_\_\_

CITY AND STATE: \_\_\_\_\_


NE  $\frac{1}{4}$  NE  $\frac{1}{4}$  Sec. 12 T. 1 ~~N.~~ E. ~~R.~~ 13 ~~W.~~, W.M.

Bearing and distance from section or subdivision corner \_\_\_\_\_

Altitude at well 345 ft.

TYPE OF WELL: drilled Date Constructed 1930

Depth drilled 70 ft. Depth cased 44 ft.

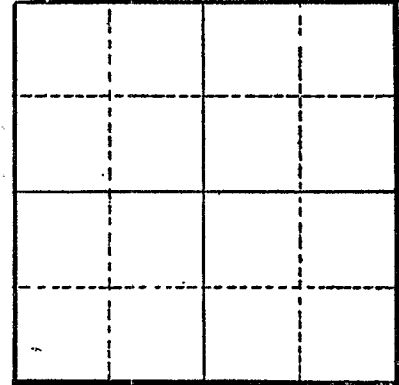

Section \_\_\_\_\_

CASING RECORD:

8-inch dia.

FINISH:

AQUIFERS:

Limestone

WATER LEVEL:

above surface

PUMPING EQUIPMENT: Type natural flow

H.P. \_\_\_\_\_

Capacity \_\_\_\_\_ G.P.M.

WELL TESTS:

Drawdown 12 ft. after 4 hours \_\_\_\_\_ 80 G.P.M.

Drawdown \_\_\_\_\_ ft. after \_\_\_\_\_ hours \_\_\_\_\_ G.P.M.

USE OF WATER Irrigation Temp. 62 °F., 19 \_\_\_\_\_

SOURCE OF INFORMATION U.S.G.S.: W.S.P. 659B.

DRILLER or DIGGER \_\_\_\_\_

ADDITIONAL DATA:

Log \_\_\_\_\_ Water Level Measurements \_\_\_\_\_ Chemical Analysis \_\_\_\_\_ Aquifer Test \_\_\_\_\_

REMARKS: 2 wells about 20 ft. apart. top of Yakima Basalt at depth of 67 ft.