

STATE ENGINEER  
Salem, Oregon

**WASCO**  
002594

**OBSERVATION WELL**  
**Well Record**

STATE WELL NO. 1N/13-17C(1)  
COUNTY Wasco  
APPLICATION NO. U-242

OWNER: George M. Davis et al

MAILING  
ADDRESS:

LOCATION OF WELL: Owner's No. \_\_\_\_\_


CITY AND  
STATE:

The Dalles

NE 1/4 NW 1/4 Sec. 17 T. 1 N. R. 13 E. W.M.

Bearing and distance from section or subdivision  
corner S 71°33' E. - 2030 feet from N.W.

corner Section 17

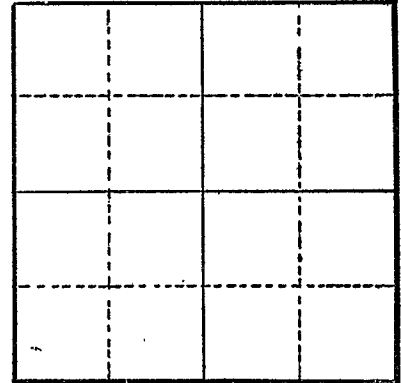

Section 17

Altitude at well 450 (Intp.)

TYPE OF WELL: drilled Date Constructed 1947-48

Depth drilled 495 Depth cased 237

**CASING RECORD:**

12-inch, set to 237 feet.

**FINISH:**

open well below casing

**AQUIFERS:**

Basalt from 466 to 472 feet

**WATER LEVEL:**

377 feet below land surface in 1948.

PUMPING EQUIPMENT: Type \_\_\_\_\_ H.P. \_\_\_\_\_

Capacity \_\_\_\_\_ G.P.M.

**WELL TESTS:**

Drawdown Head of 4 ft. after 40 min ~~Hours~~ recharging 1,000 G.P.M.

Drawdown \_\_\_\_\_ ft. after \_\_\_\_\_ hours \_\_\_\_\_ G.P.M.

USE OF WATER Irrigation - Priority 7-9-47 Temp. \_\_\_\_\_ °F. \_\_\_\_\_, 19\_\_\_\_

SOURCE OF INFORMATION U-242, permit U-217 Certificate 22840

DRILLER or DIGGER \_\_\_\_\_

**ADDITIONAL DATA:**

Log  Water Level Measurements  Chemical Analysis \_\_\_\_\_ Aquifer Test \_\_\_\_\_

**REMARKS:**